


TRAFFIC CONTROL PLAN
FOR
LAGUNA STREET SEWER REPLACEMENT AND
WEST SIDE SEWER LATERAL CONNECTION/REPLACEMENT AT
LAGUNA ST. FROM PACIFIC AVE. TO JACTON STREET

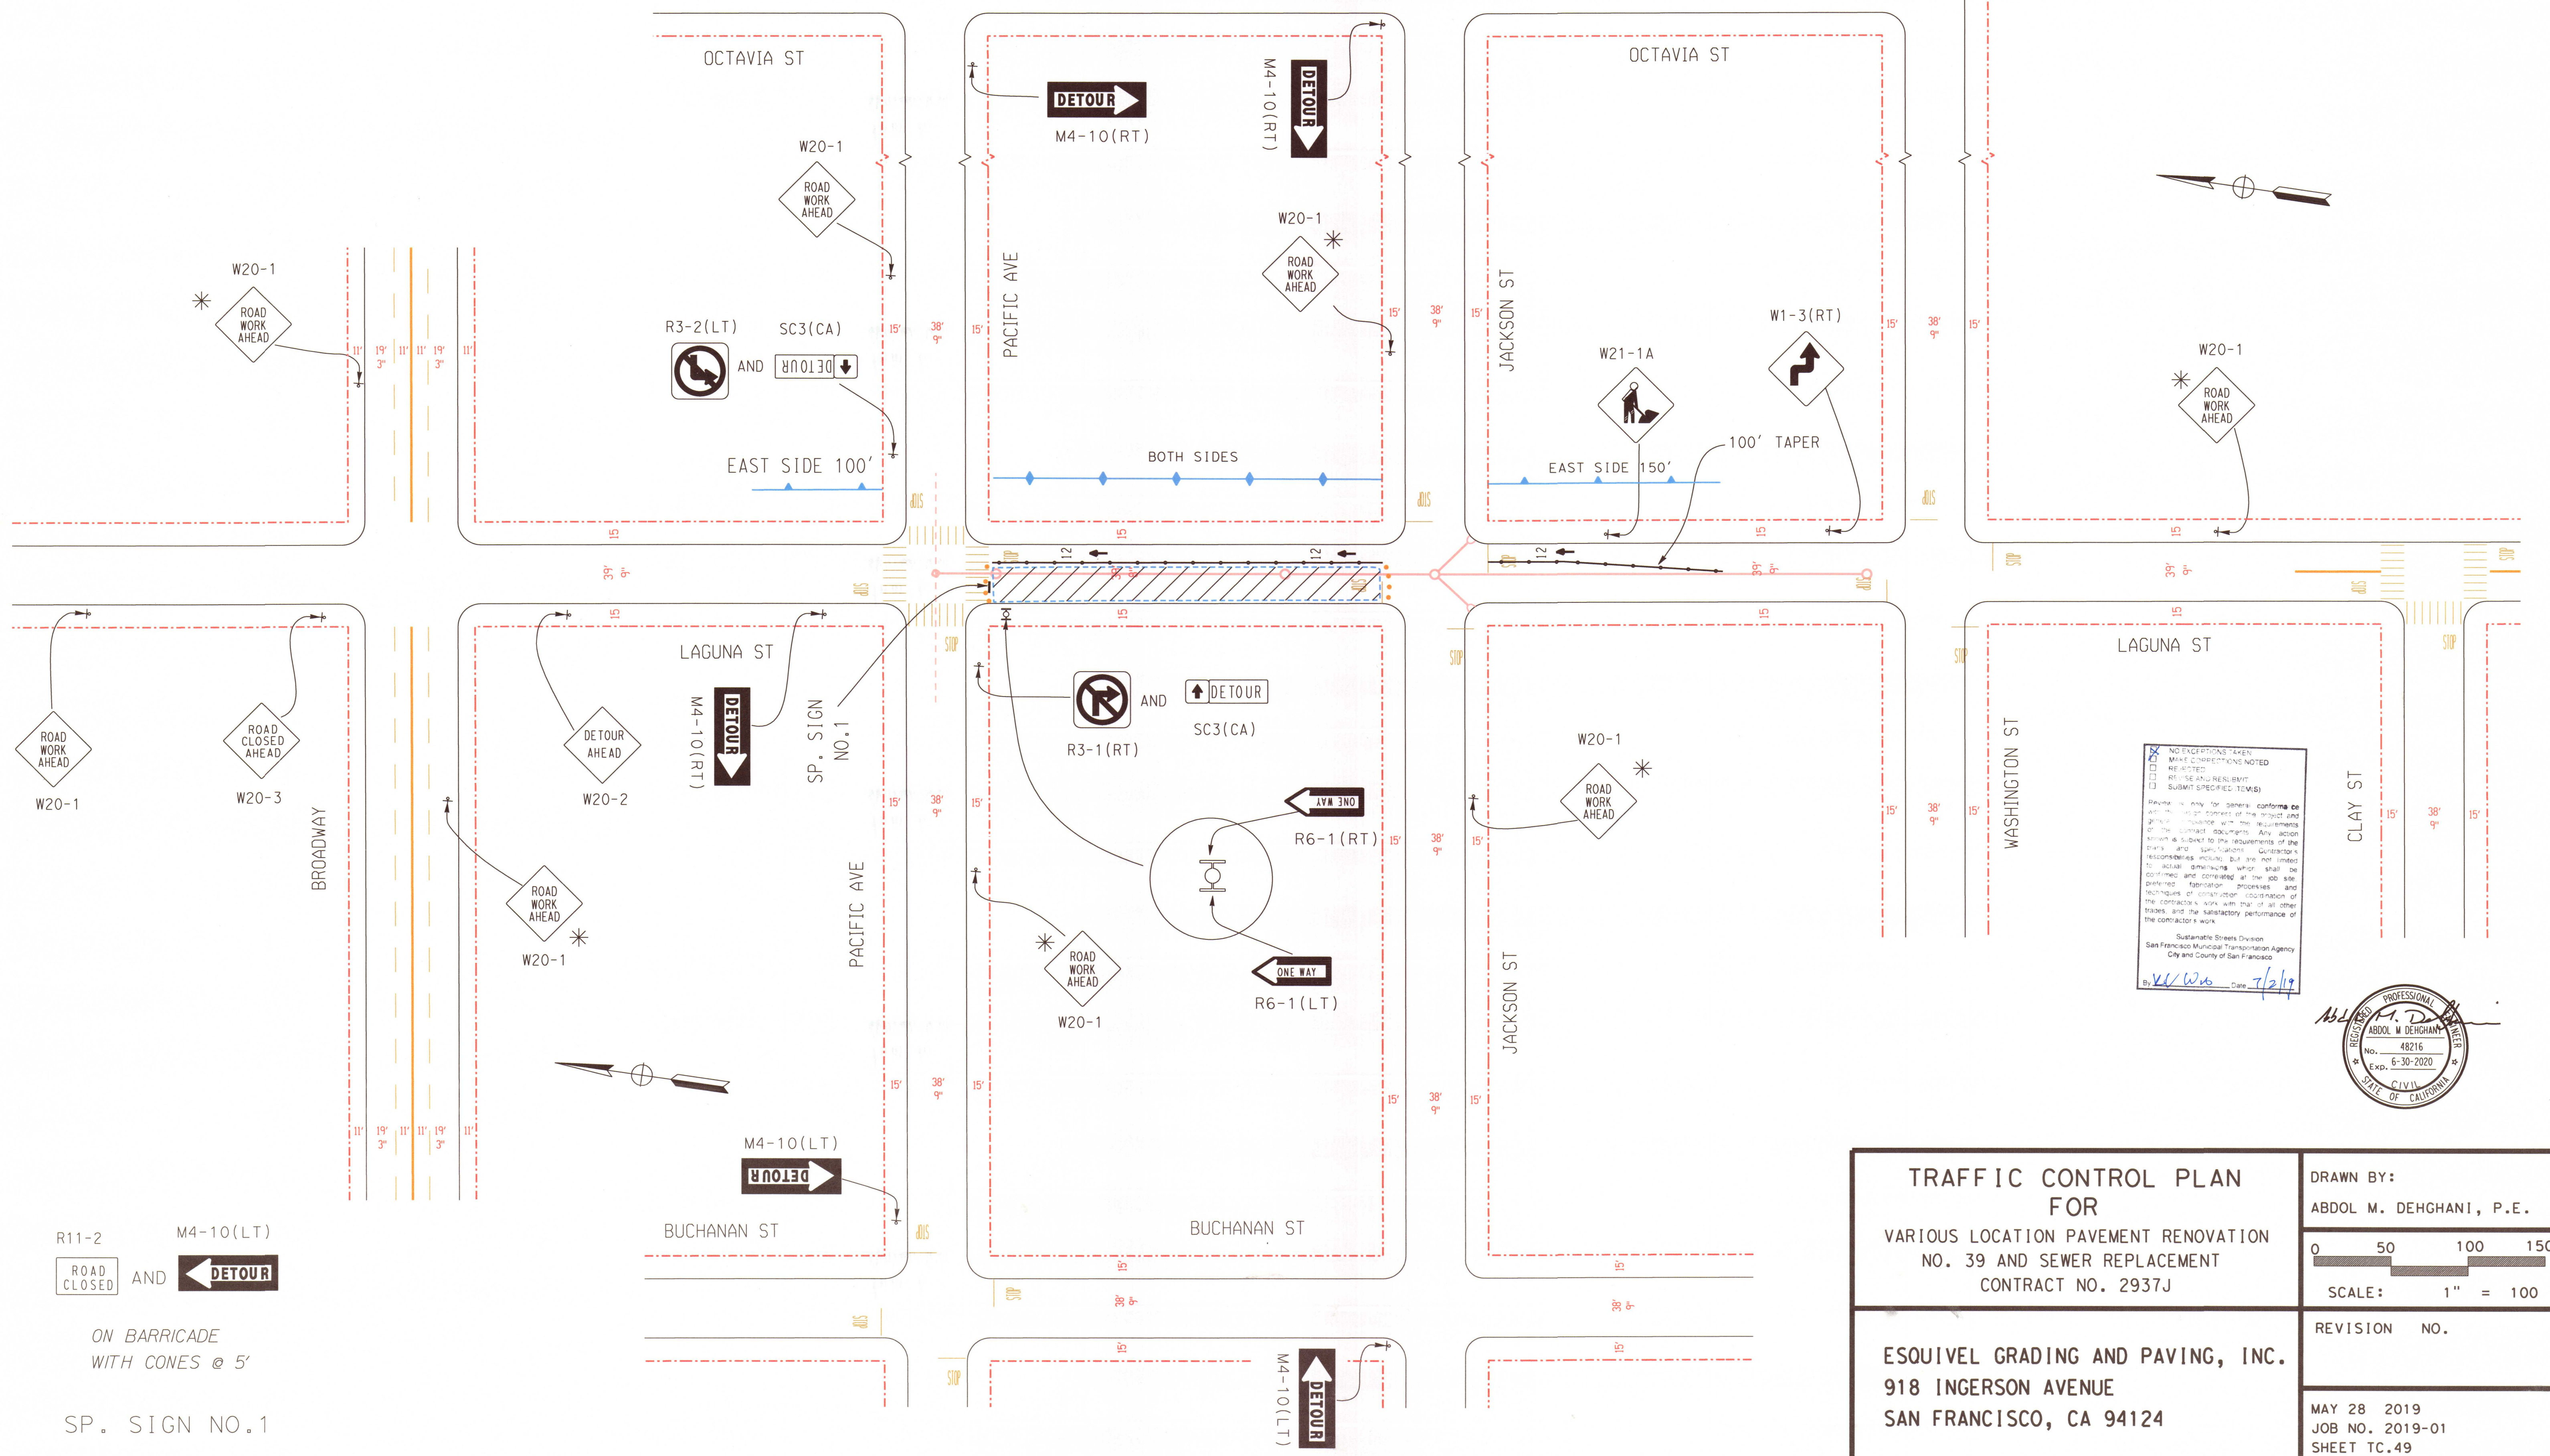


NO EXCEPTIONS TAKEN
MAKE CORRECTIONS NOTED
REJECTED
REVISE AND RESUBMIT
SUBMIT SPECIFIED ITEMS

Planner is only for general reference. It is not to be used as a basis for design or construction. Any action taken on the basis of this plan is at the user's risk. The user shall be responsible for the accuracy of the information and the results of the work. The user shall be responsible for the safety of the work and the satisfaction of the contractor's work.

Sustainable Streets Division
San Francisco Municipal Transportation Agency
City and County of San Francisco

By: *W. W. W.* Date: *7/2/19*

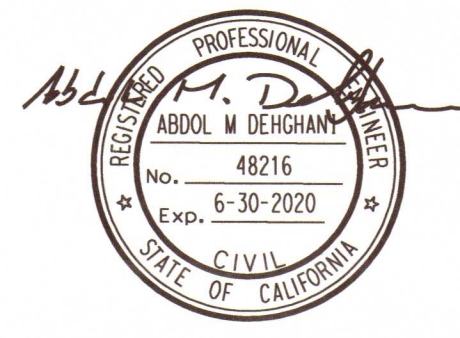

TRAFFIC CONTROL PLAN FOR VARIOUS LOCATION PAVEMENT RENOVATION NO. 39 AND SEWER REPLACEMENT CONTRACT NO. 2937J	
ESQUIVEL GRADING AND PAVING, INC. 918 INGERSON AVENUE SAN FRANCISCO, CA 94124	DRAWN BY: ABDOL M. DEHGHANI, P.E. 0 50 100 150 SCALE: 1" = 100' REVISION NO. MAY 28 2019 JOB NO. 2019-01 SHEET TC.49