


Laguna St. should have 2 lanes at 10' each

NO EXCHANGES, ETC.  
MAKE CORRECTIONS NOTED  
REJECTED  
REVISED AND RESUBMIT  
SUBMIT SPECIFIC ITEMS

Review is only for general conformance with the project and the requirements of the contract documents. Any action taken by the engineer shall be based on the requirements of the contract documents and the requirements of the State of California. The engineer is not responsible for the accuracy of the information provided by the contractor or for the accuracy of the information provided by the contractor's subcontractors. The engineer is not responsible for the accuracy of the information provided by the contractor's subcontractors. The engineer is not responsible for the accuracy of the information provided by the contractor's subcontractors.

Sustainable Streets Division  
San Francisco Municipal Transportation Agency  
City and County of San Francisco

By KW Date 7/3/19

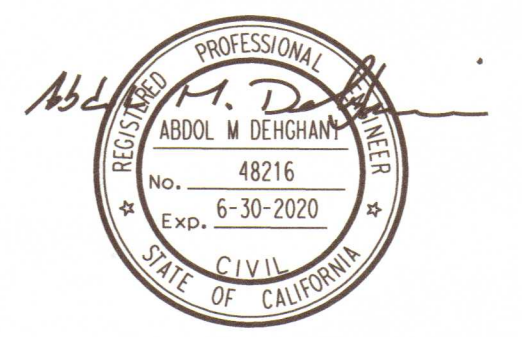

<b>TRAFFIC CONTROL PLAN FOR VARIOUS LOCATION PAVEMENT RENOVATION NO. 39 AND SEWER REPLACEMENT CONTRACT NO. 2937J</b>		<b>DRAWN BY:</b> ABDOL M. DEGHANI, P.E.
<b>ESQUIVEL GRADING AND PAVING, INC.</b> 918 INGERSON AVENUE SAN FRANCISCO, CA 94124		<b>REVISION NO. 1</b> JULY 25, 2019
		July 15, 2019 JOB NO. 2019-01 SHEET TC.88 - REVISED