
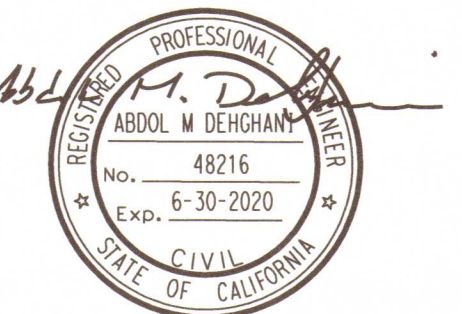


# TRAFFIC CONTROL PLAN FOR

WEST SIDE SEWER LATERAL CONNECTION/REPLACEMENT AT  
LAGUNA ST. FROM SACRAMENTO TO CALIFORNIA STREETS

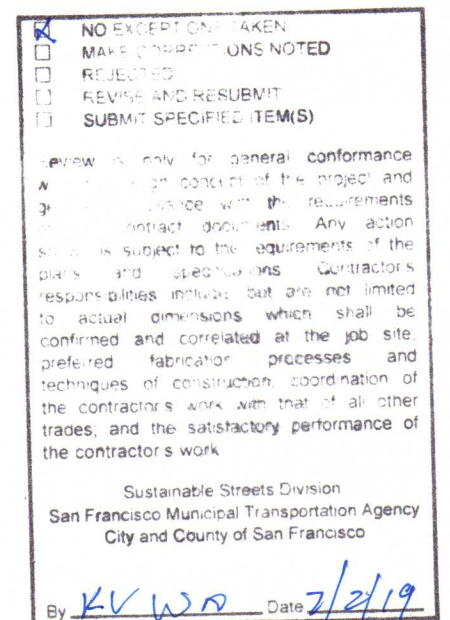

TRAFFIC CONTROL PLAN  
FOR  
VARIOUS LOCATION PAVEMENT RENOVATION  
NO. 39 AND SEWER REPLACEMENT  
CONTRACT NO. 2937J

ESQUIVEL GRADING AND PAVING, INC.  
918 INGERSON AVENUE  
SAN FRANCISCO, CA 94124

DRAWN BY:  
ABDOL M. DEGHANI, P.E.

0 50 100 150

SCALE: 1" = 100'

REVISION	NO.
MAY 28, 2019	
JOB NO. 2019-01	
SHEET TC.53	