

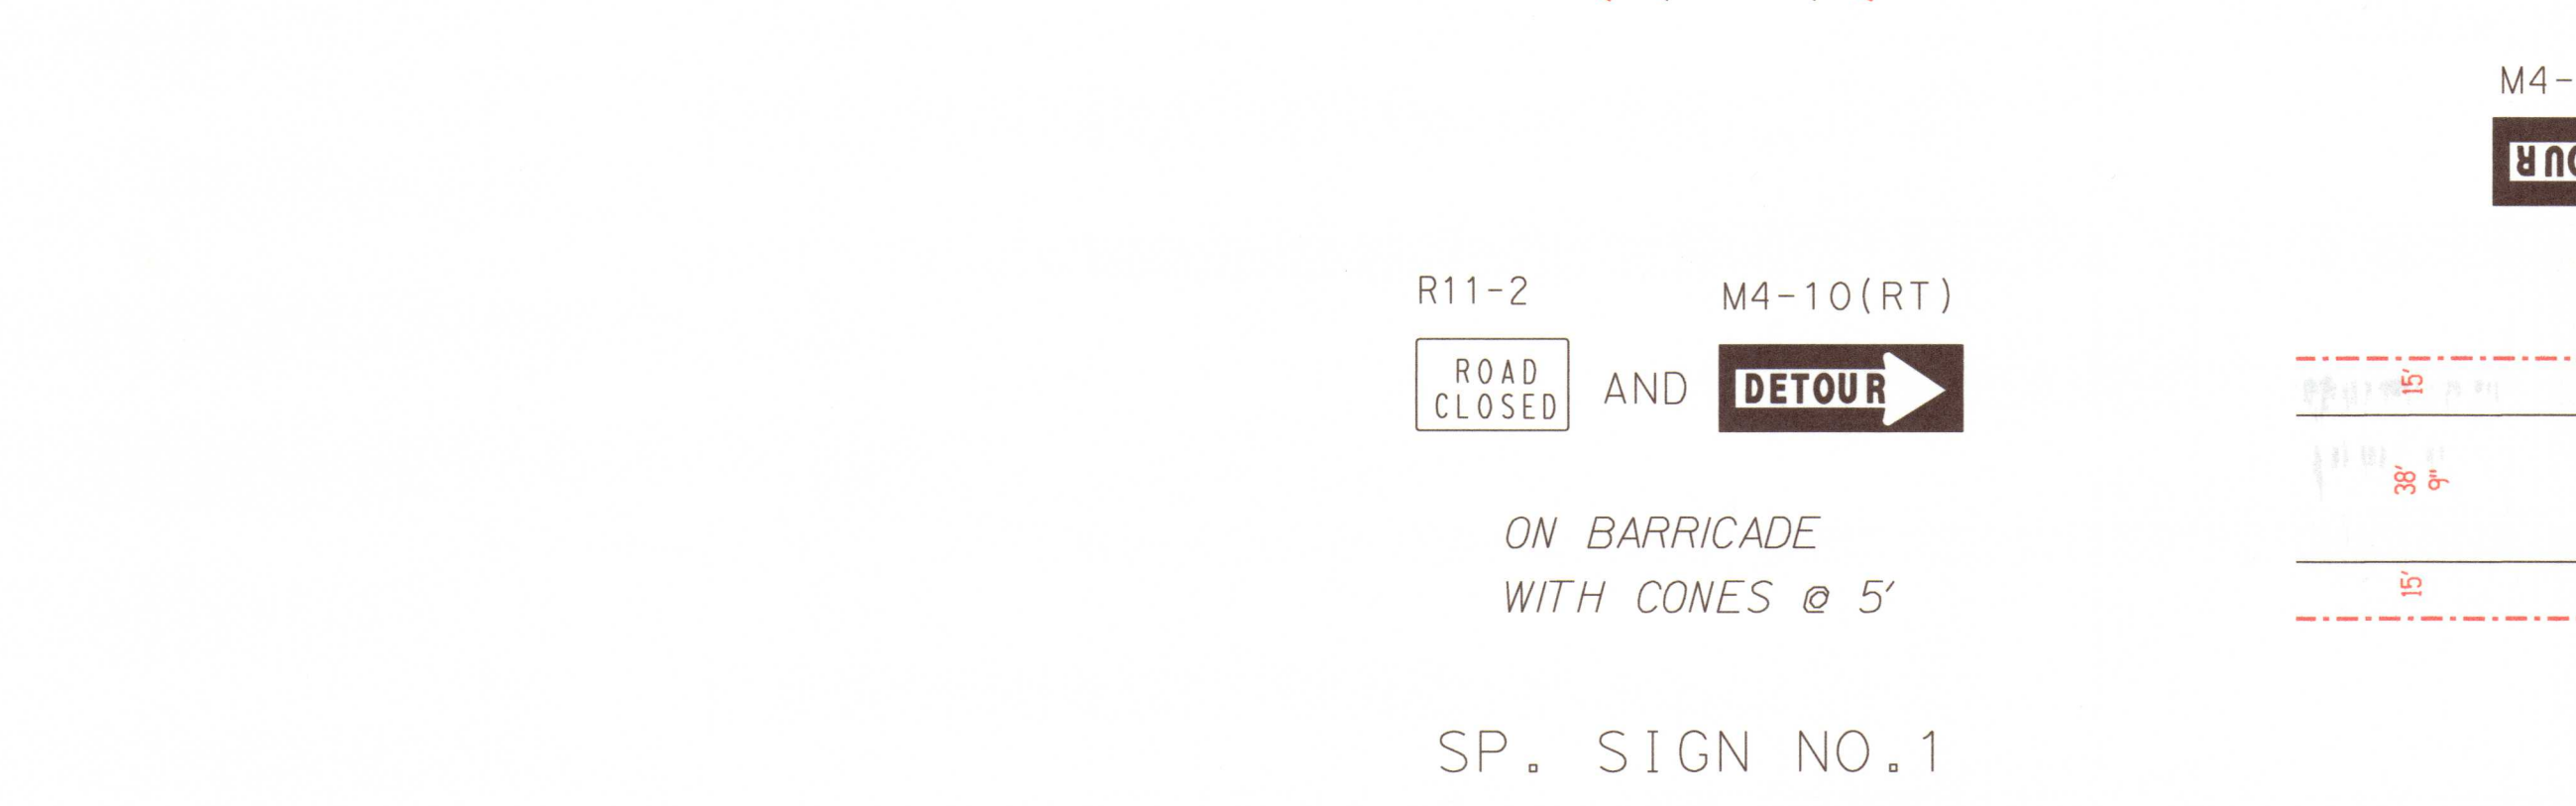
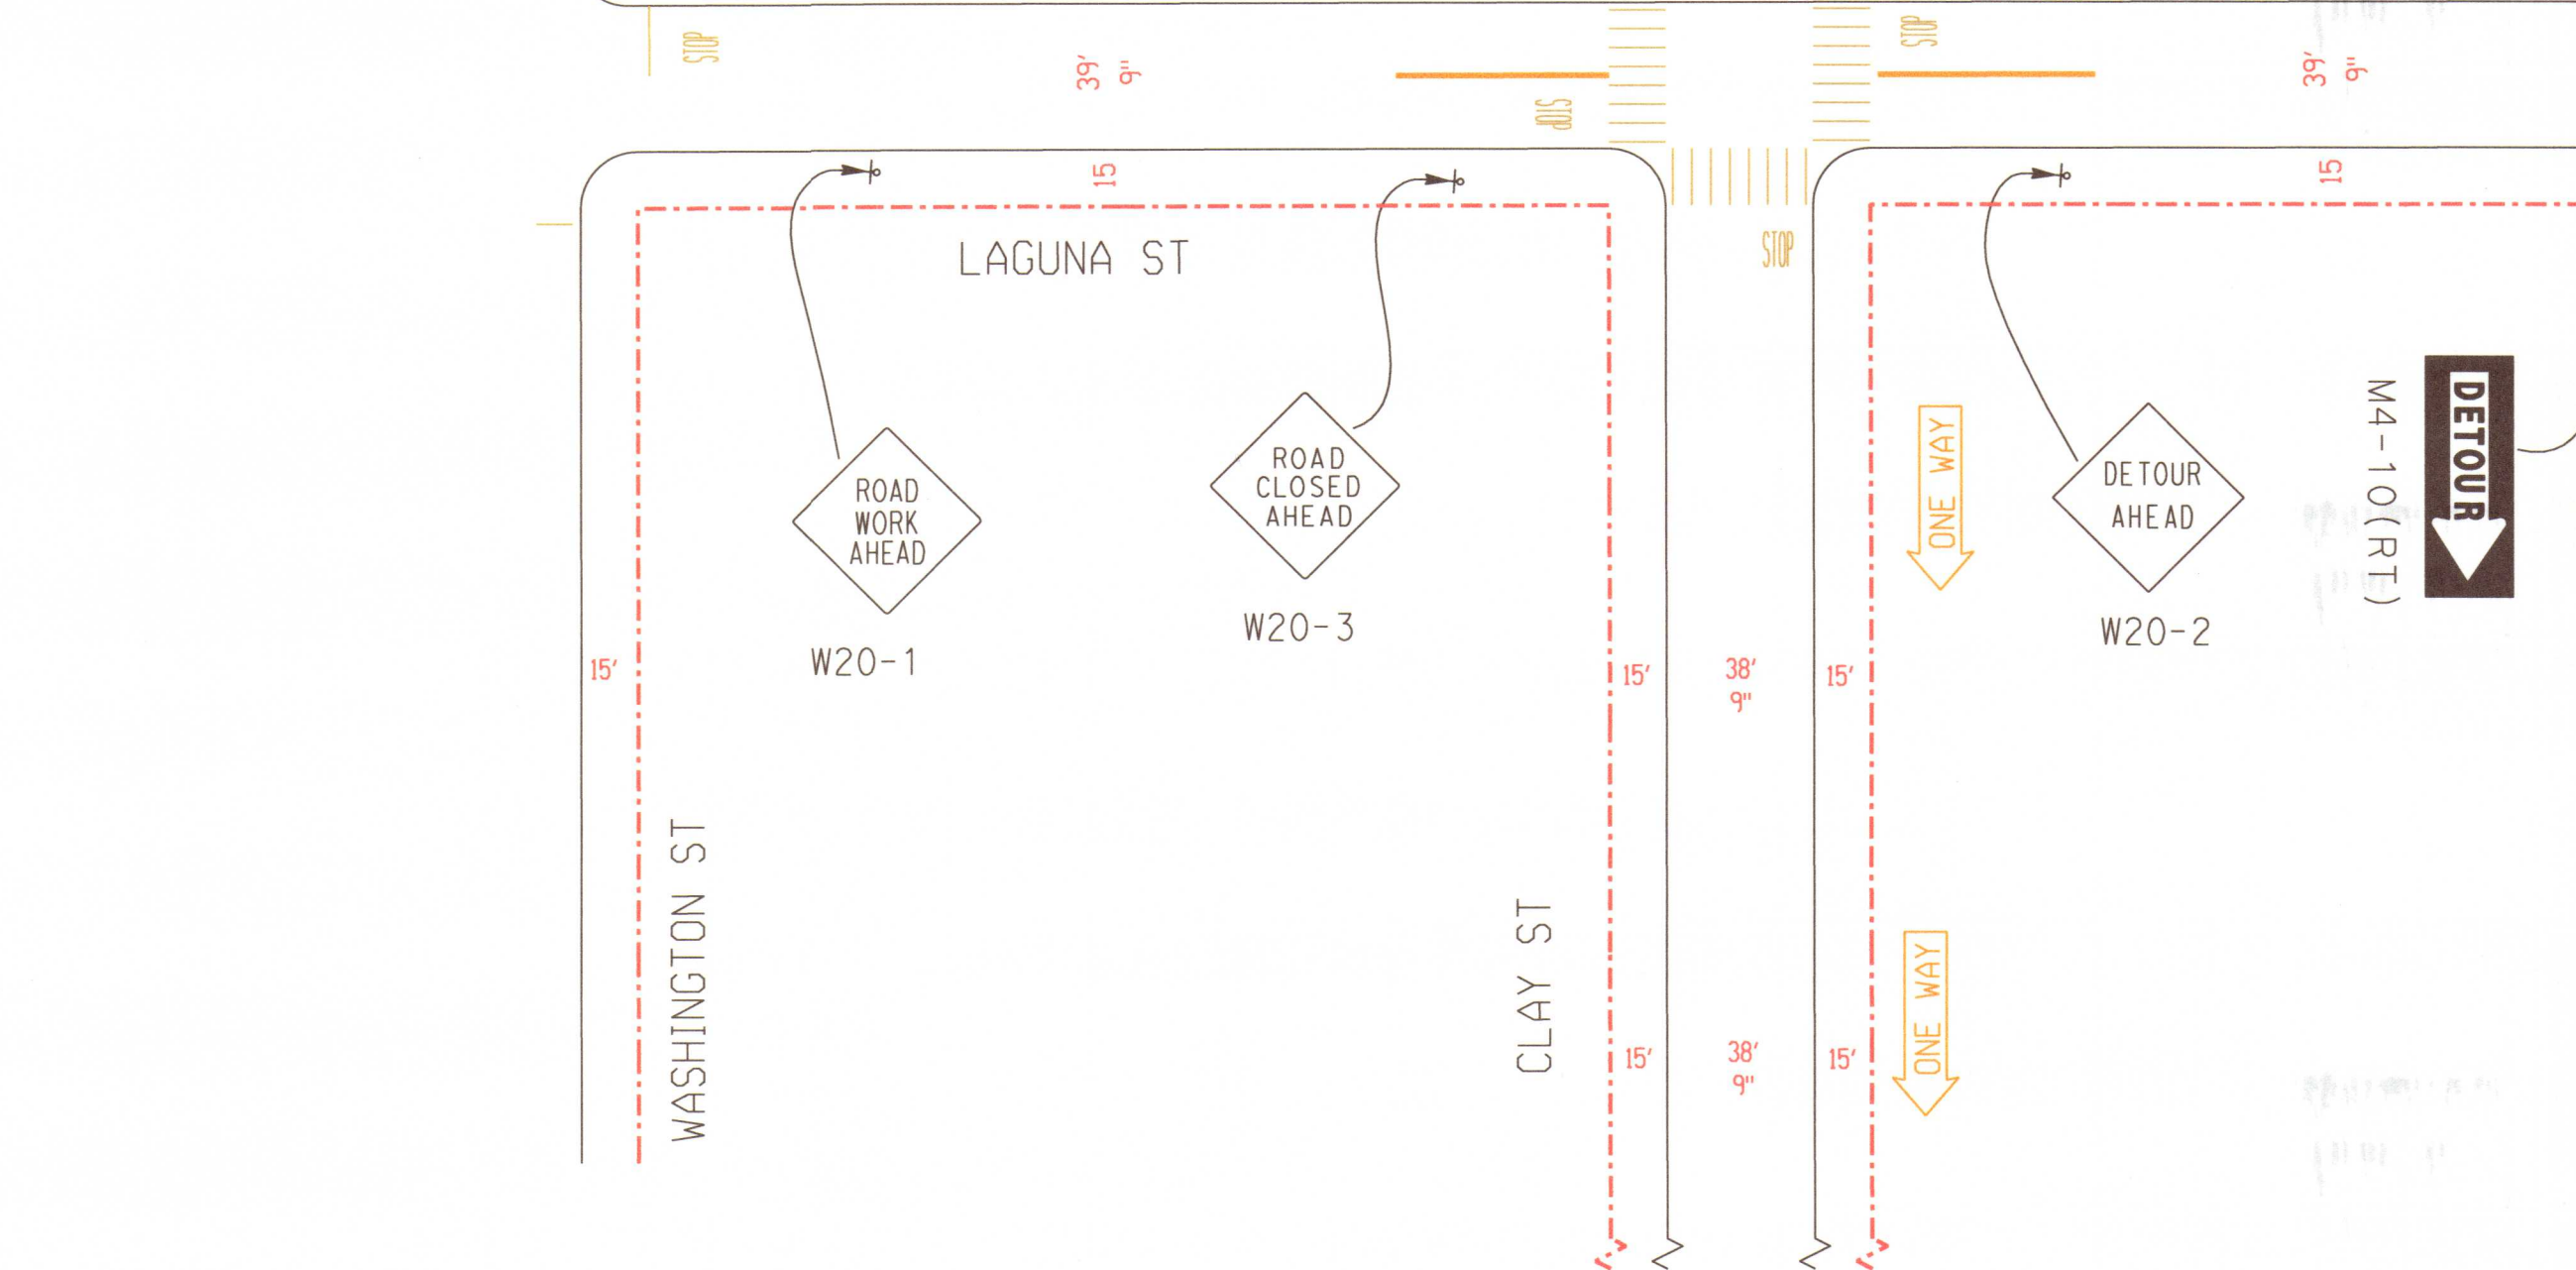
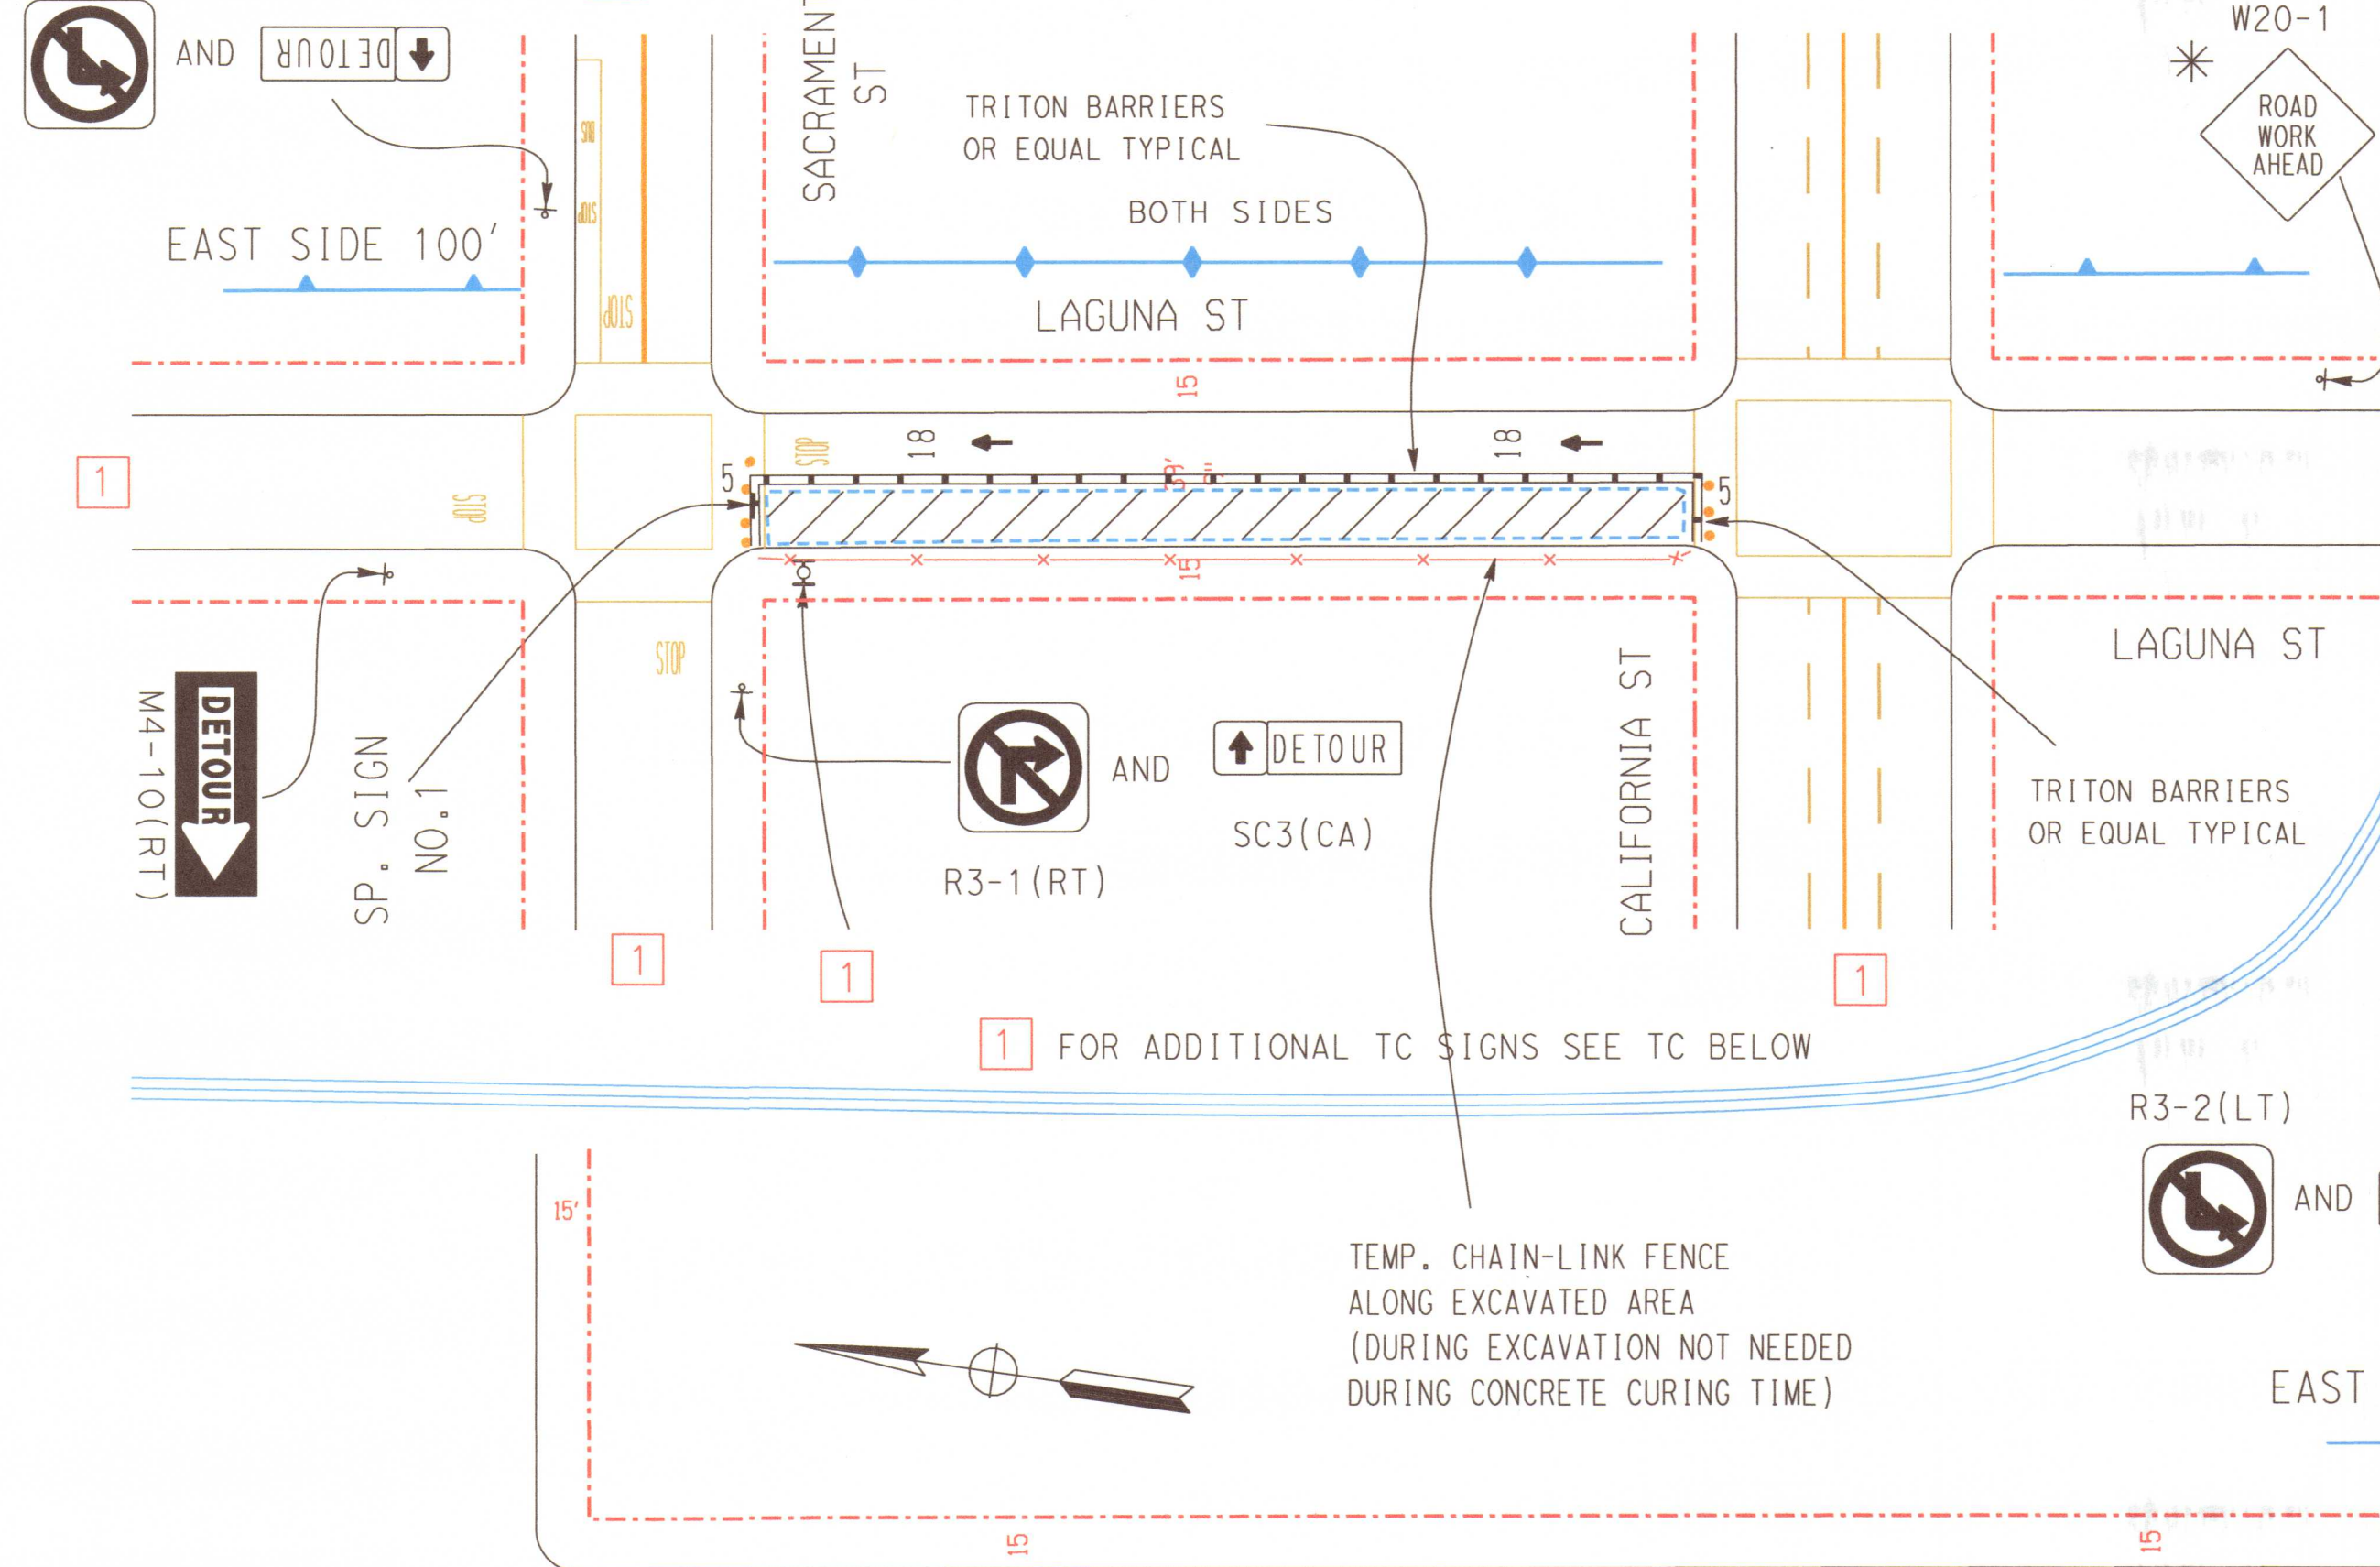
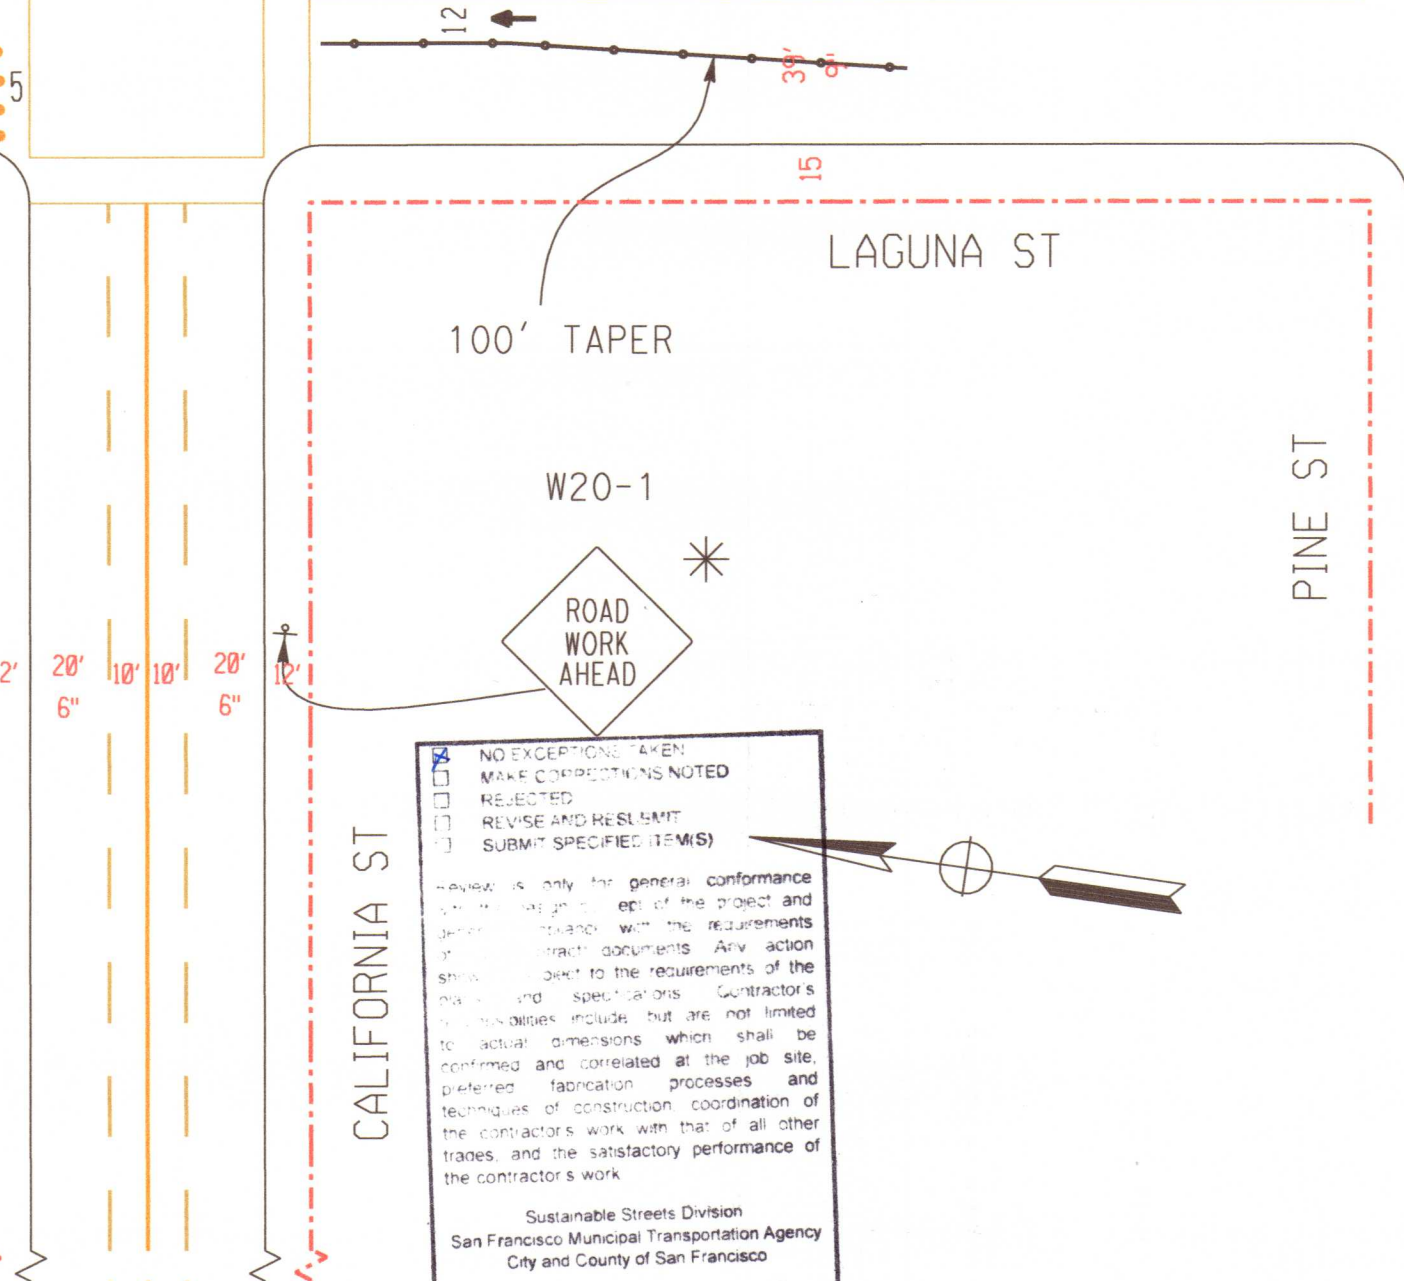
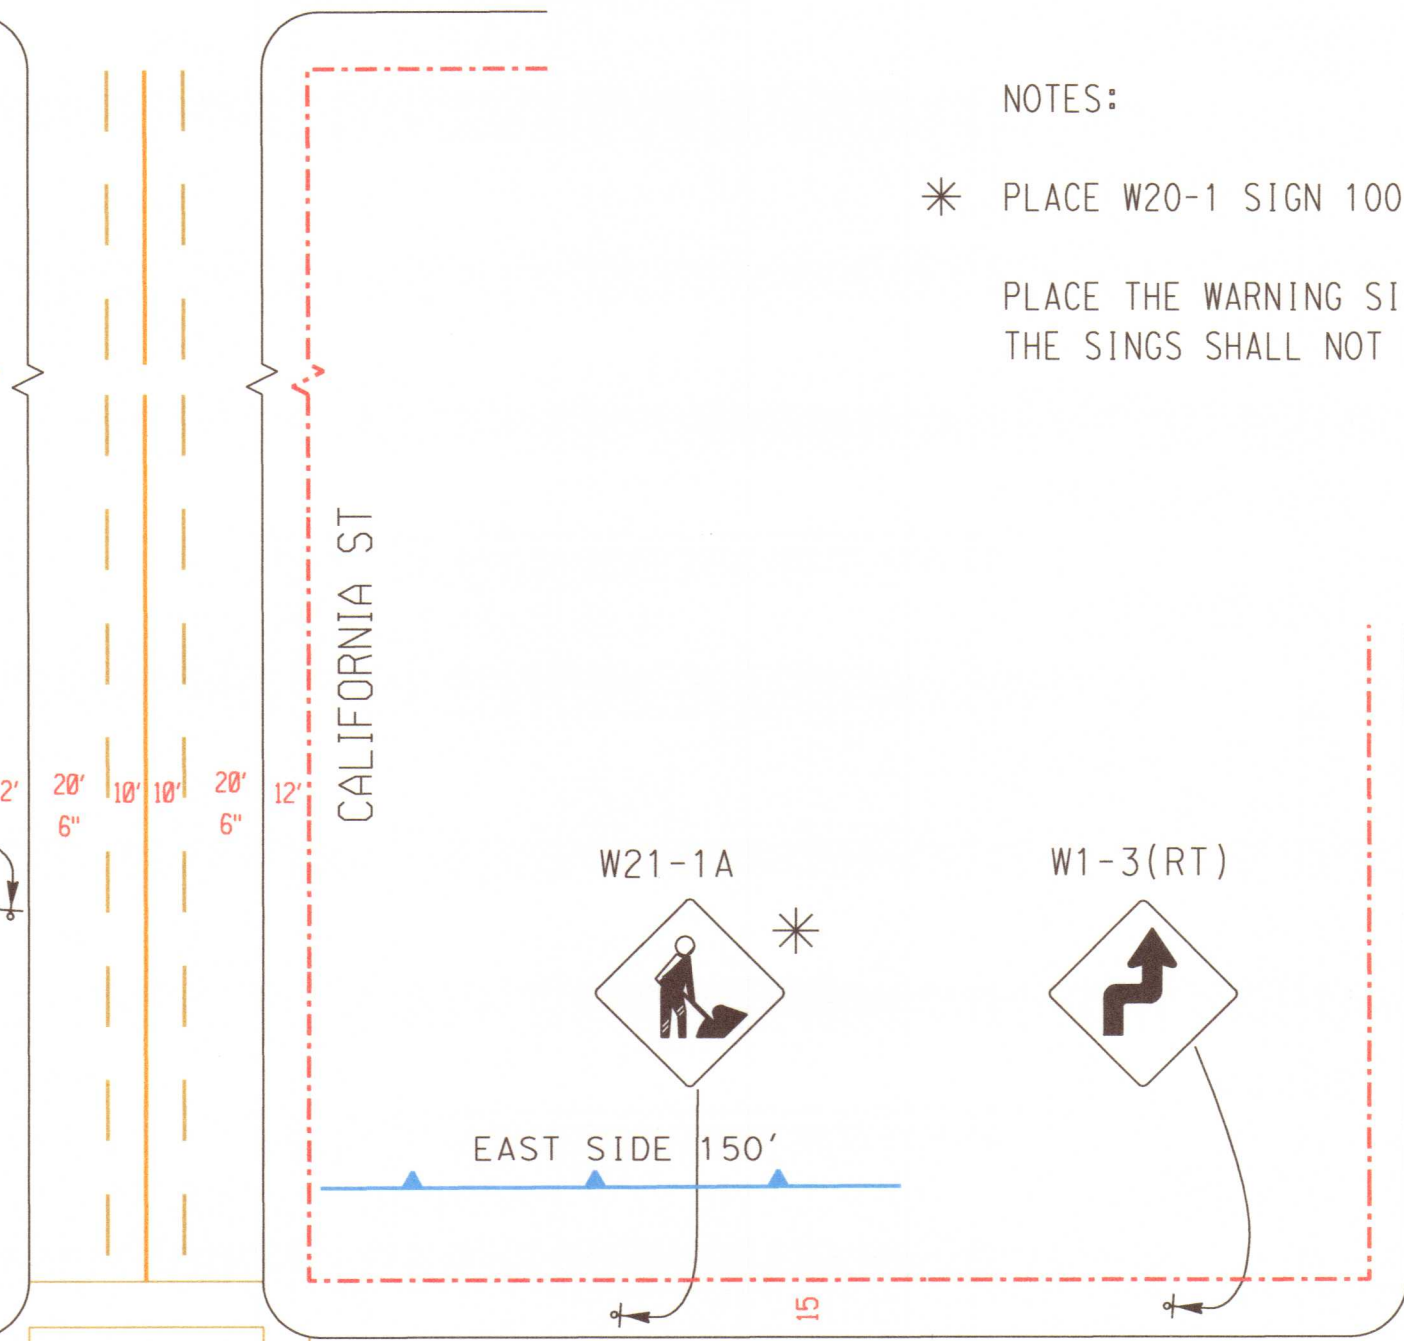
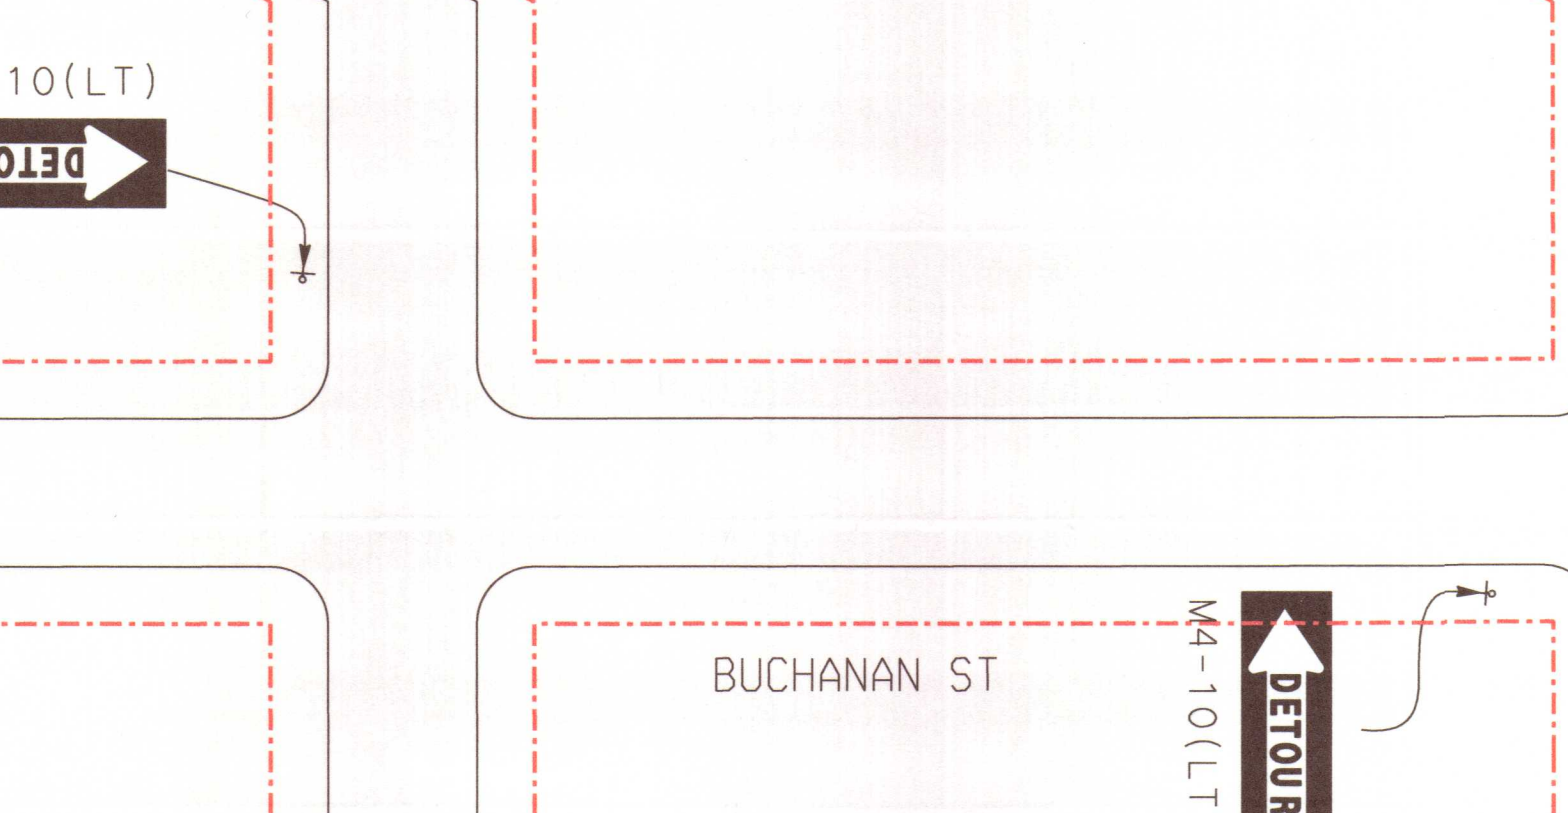


R3-2(LT) SC3(CA) PHASE "A" DURING NON - WORKING HOURS

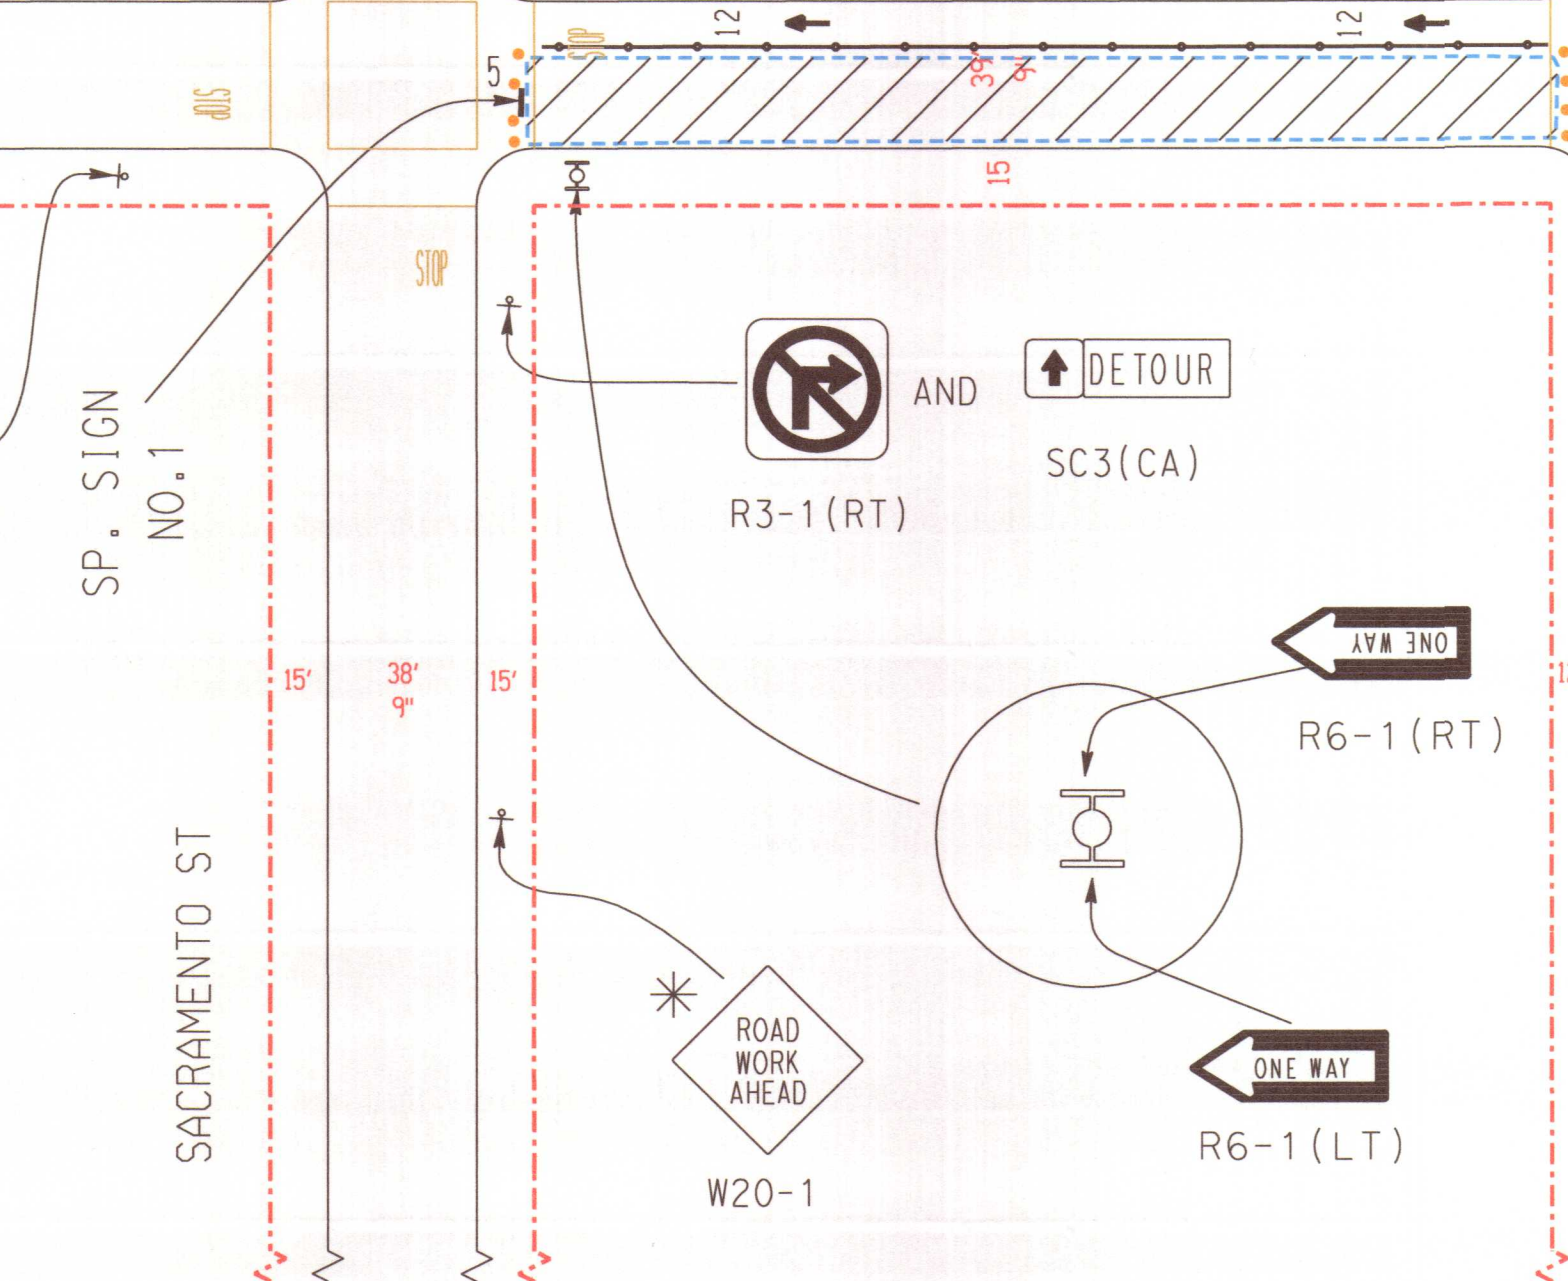

TRAFFIC CONTROL PLAN FOR LAGUNA STREET CONCRETE PAVEMENT RECONSTRUCTION AT WEST SIDE OF LAGUNA ST. FROM SACRAMENTO TO CALIFORNIA STREETS PHASE "A" DURING WORKING HOURS

- NOTES:
- * PLACE W20-1 SIGN 100' (MIN) FROM THE INTERSECTION
 - PLACE THE WARNING SINGS AT 100' TO 150' FROM EACH OTHER. THE SINGS SHALL NOT BLOCK ANY DRIVEWAY.

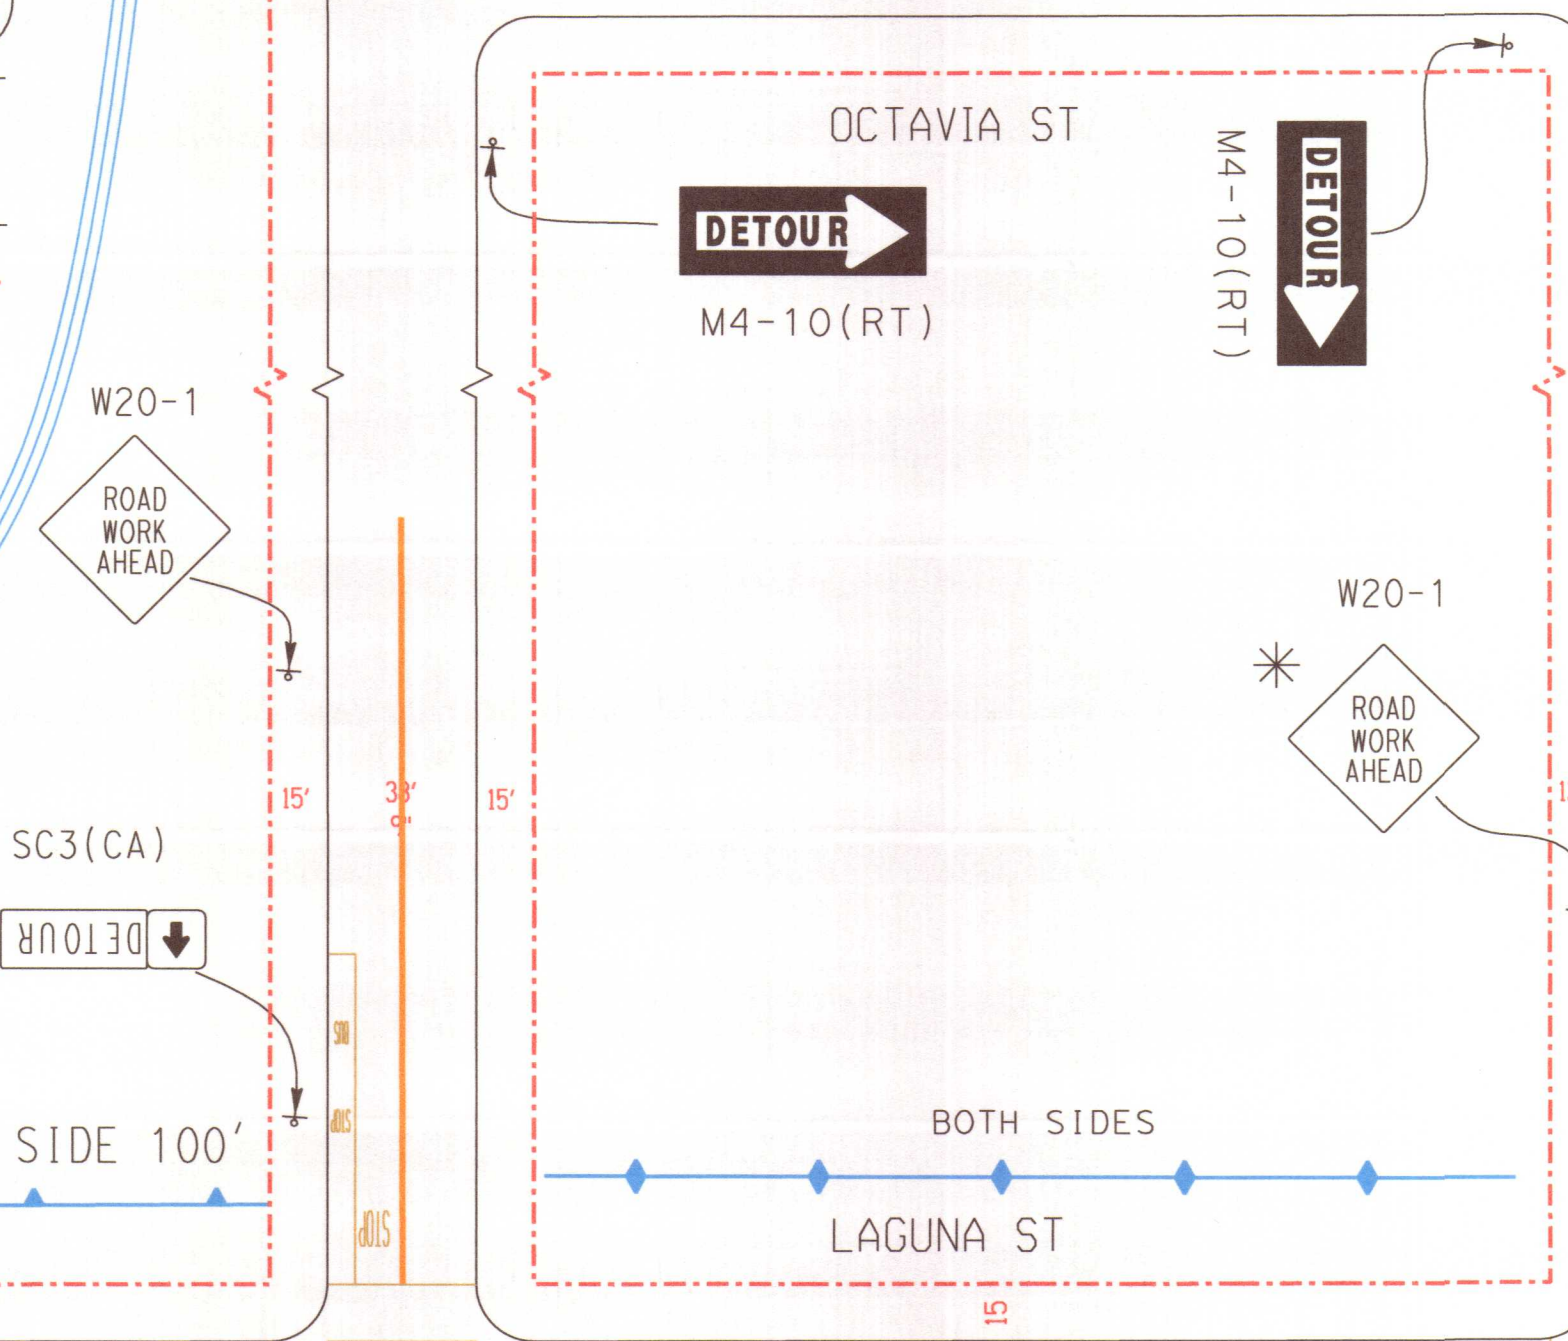


NO EXCEPTIONS TAKEN
MAKE CORRECTIONS NOTED
REJECTED
REVISED AND REBUILT
SUBMIT SPECIFIC ITEMS

Reviewed by only for general conformance
and not for specific details of the project and
any other documents with the requirements of
the project. The contractor is responsible for
the accuracy of the information provided and
the contractor's compliance with the requirements
of the project. The contractor is responsible for
the accuracy of the information provided and
the contractor's compliance with the requirements
of the project.

Sustainable Streets Division
San Francisco Municipal Transportation Agency
City and County of San Francisco

By: *[Signature]* Date: 8/14/19

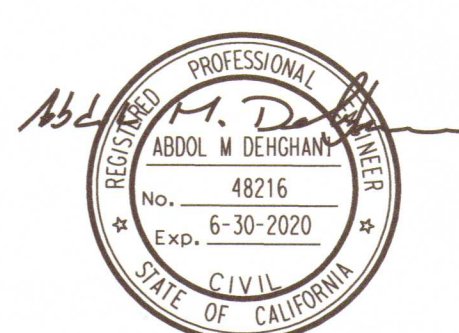

TRAFFIC CONTROL PLAN FOR VARIOUS LOCATION PAVEMENT RENOVATION NO. 39 AND SEWER REPLACEMENT CONTRACT NO. 2937J	DRAWN BY: ABDOL M. DEGHANI, P.E.	
	0 50 100 150 SCALE: 1" = 100	
ESQUIVEL GRADING AND PAVING, INC. 918 INGERSON AVENUE SAN FRANCISCO, CA 94124	REVISION NO.	
	JULY 31, 2019 JOB NO. 2019-01 SHEET TC.98	