


TRAFFIC CONTROL PLAN
FOR
LAGUNA STREET CONCRETE PAVEMENT RECONSTRUCTION AT
WEST SIDE OF LAGUNA ST. FROM PACIFIC AVE. TO JACTON STREET
PHASE "A"
DURING WORKING HOURS

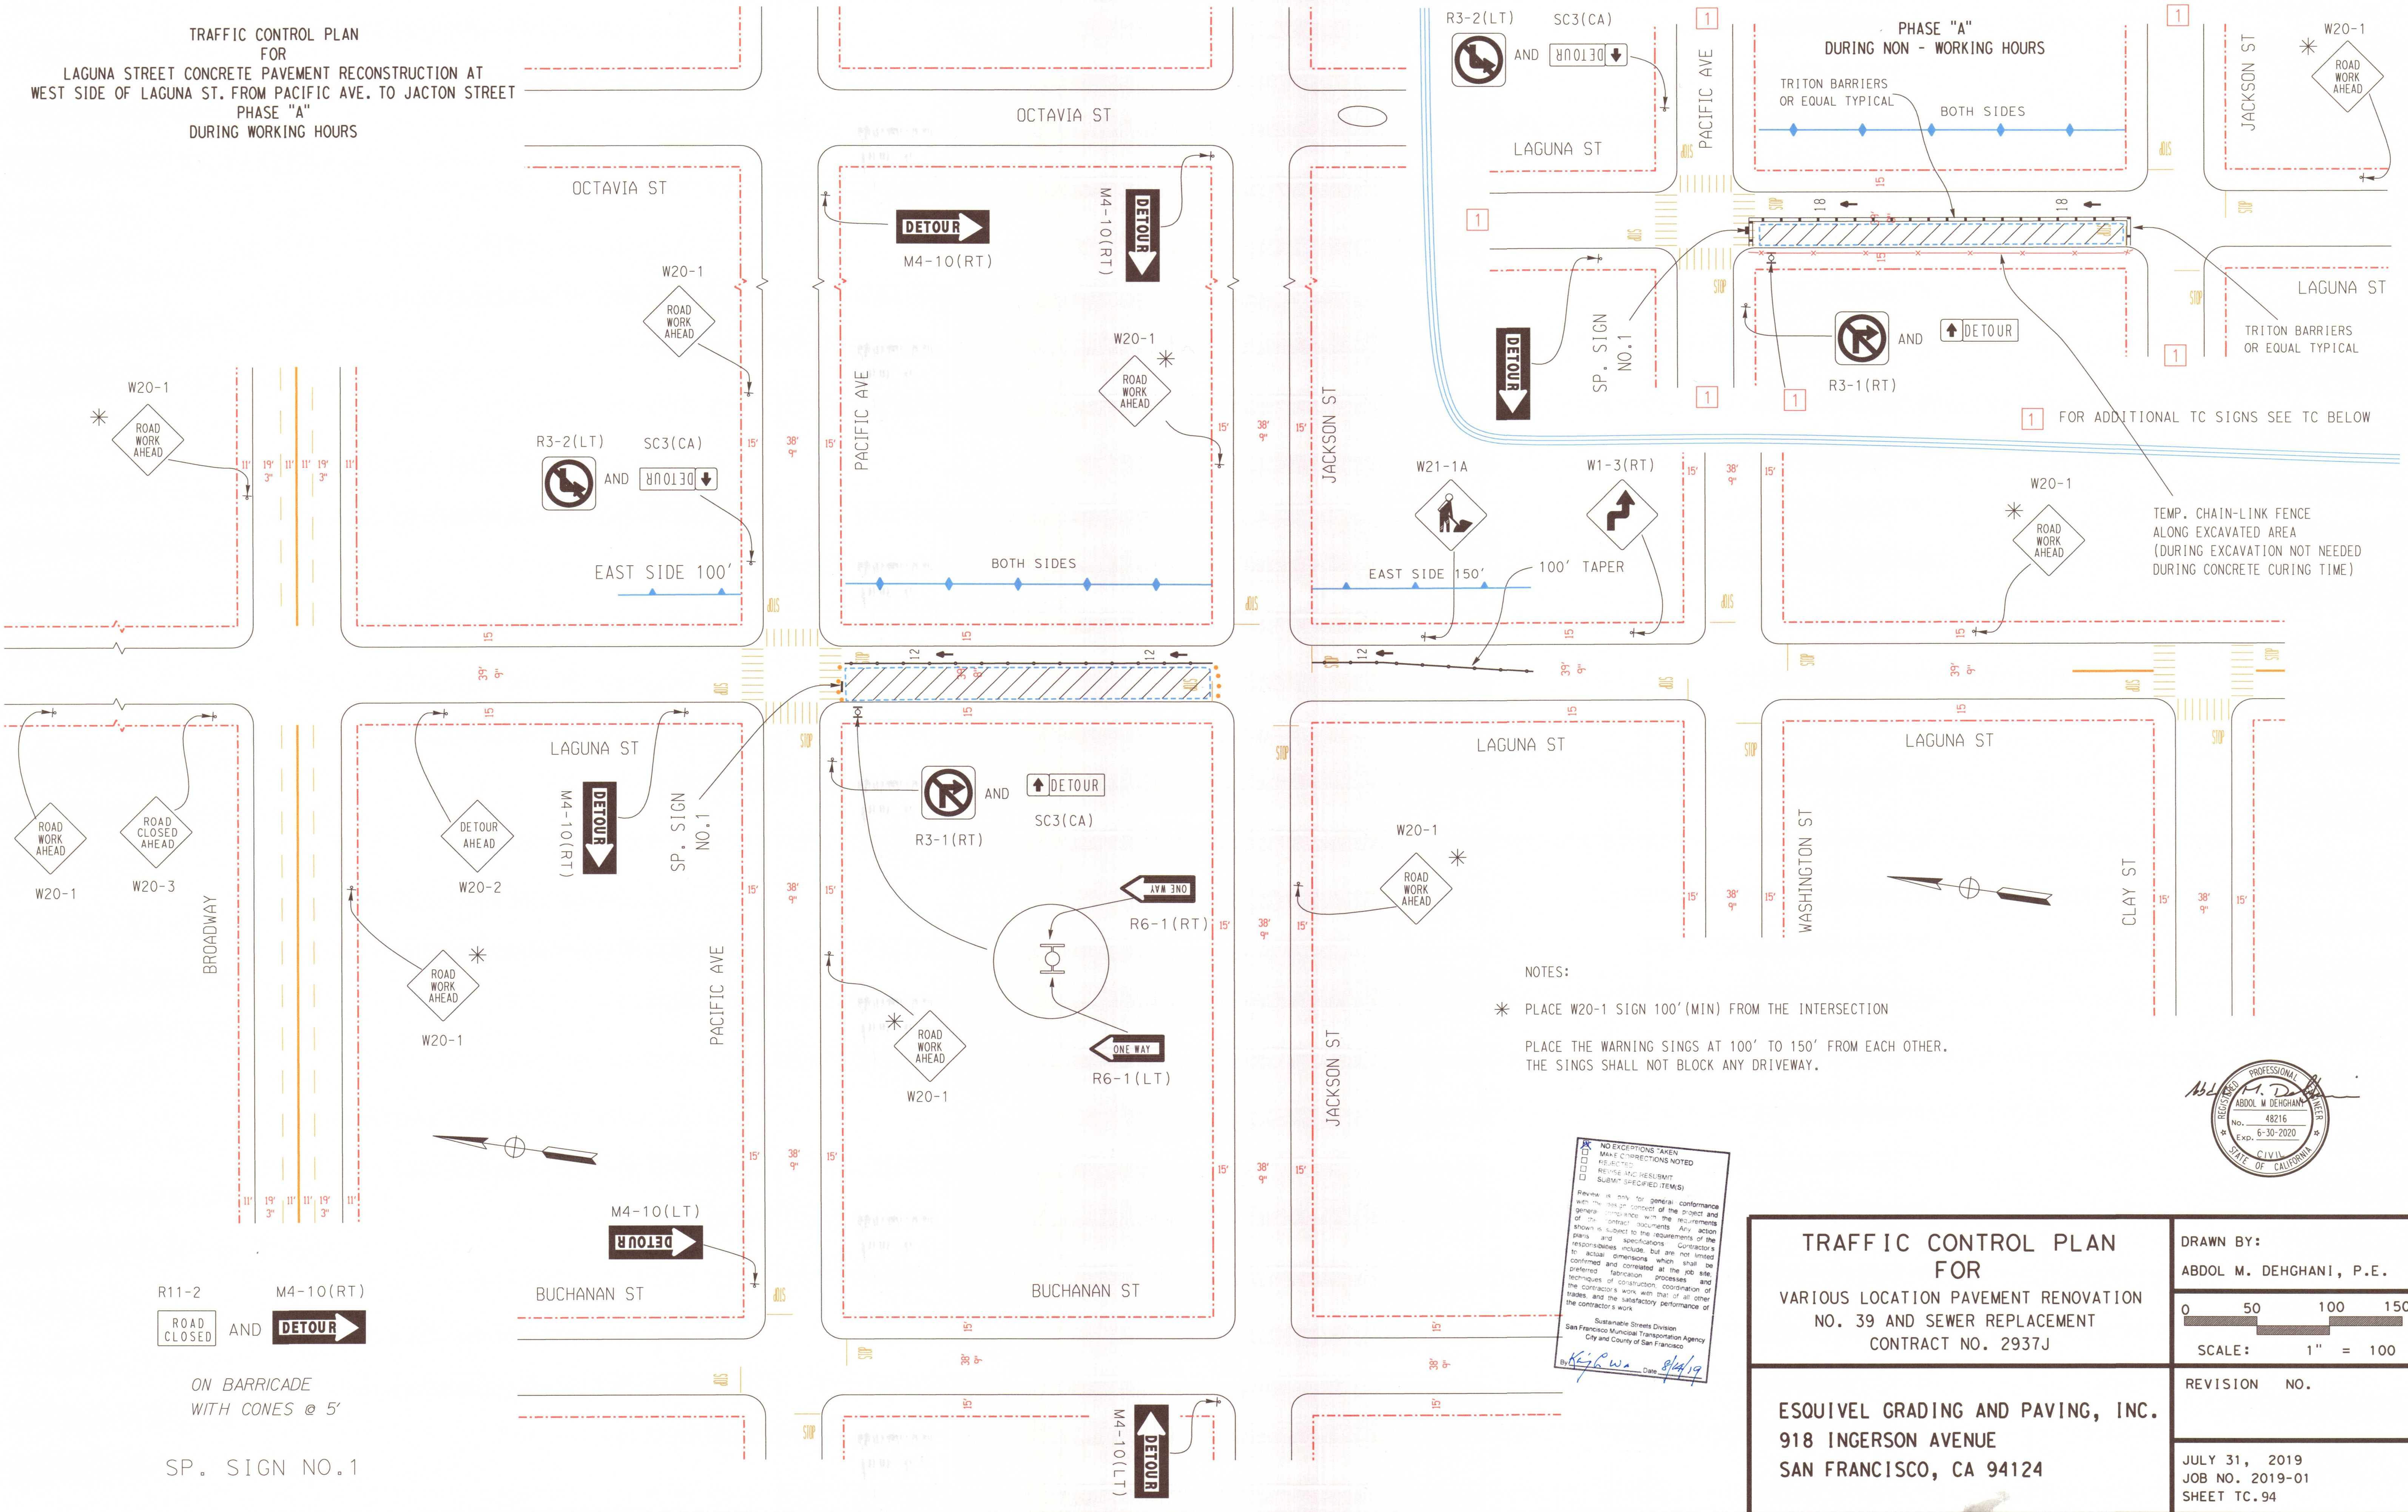

NOTES:
* PLACE W20-1 SIGN 100' (MIN) FROM THE INTERSECTION
PLACE THE WARNING SINGS AT 100' TO 150' FROM EACH OTHER.
THE SINGS SHALL NOT BLOCK ANY DRIVEWAY.

NO EXCEPTIONS TAKEN
MAKE CORRECTIONS NOTED
REJECTED
REVISE AND RESUBMIT
SUBMIT SPECIFIED ITEMS

Review is only for general conformance with the design contract of the project and of the contract documents. Any action shown is subject to the requirements of the responsibilities include, but are not limited to: actual dimensions which shall be confirmed and correlated at the job site; preferred fabrication processes; and the contractor's work with that of all other the contractor's work.

Sustainable Streets Division
San Francisco Municipal Transportation Agency
City and County of San Francisco

By: *Keya* Date: *8/4/19*

TRAFFIC CONTROL PLAN FOR VARIOUS LOCATION PAVEMENT RENOVATION NO. 39 AND SEWER REPLACEMENT CONTRACT NO. 2937J	DRAWN BY: ABDOL M. DEGHANI, P.E.
	SCALE: 0 50 100 150 1" = 100'
	REVISION NO.
ESQUIVEL GRADING AND PAVING, INC. 918 INGERSON AVENUE SAN FRANCISCO, CA 94124	JULY 31, 2019 JOB NO. 2019-01 SHEET TC.94

