


ALTERNATIVE TRAFFIC CONTROL PLAN  
FOR  
PINE STREET CURB RAMP RECONSTRUCTION AT  
BUCHANAN, LAGUNA AND OCTAVIA STS. INTERSECTIONS  
PHASE "B"  
DURING NON-WORKING HOURS



NO EXCEPTIONS & REV.  
MAKE CORRECTIONS NOTED  
REVISIONS  
DATE: 5/21/19

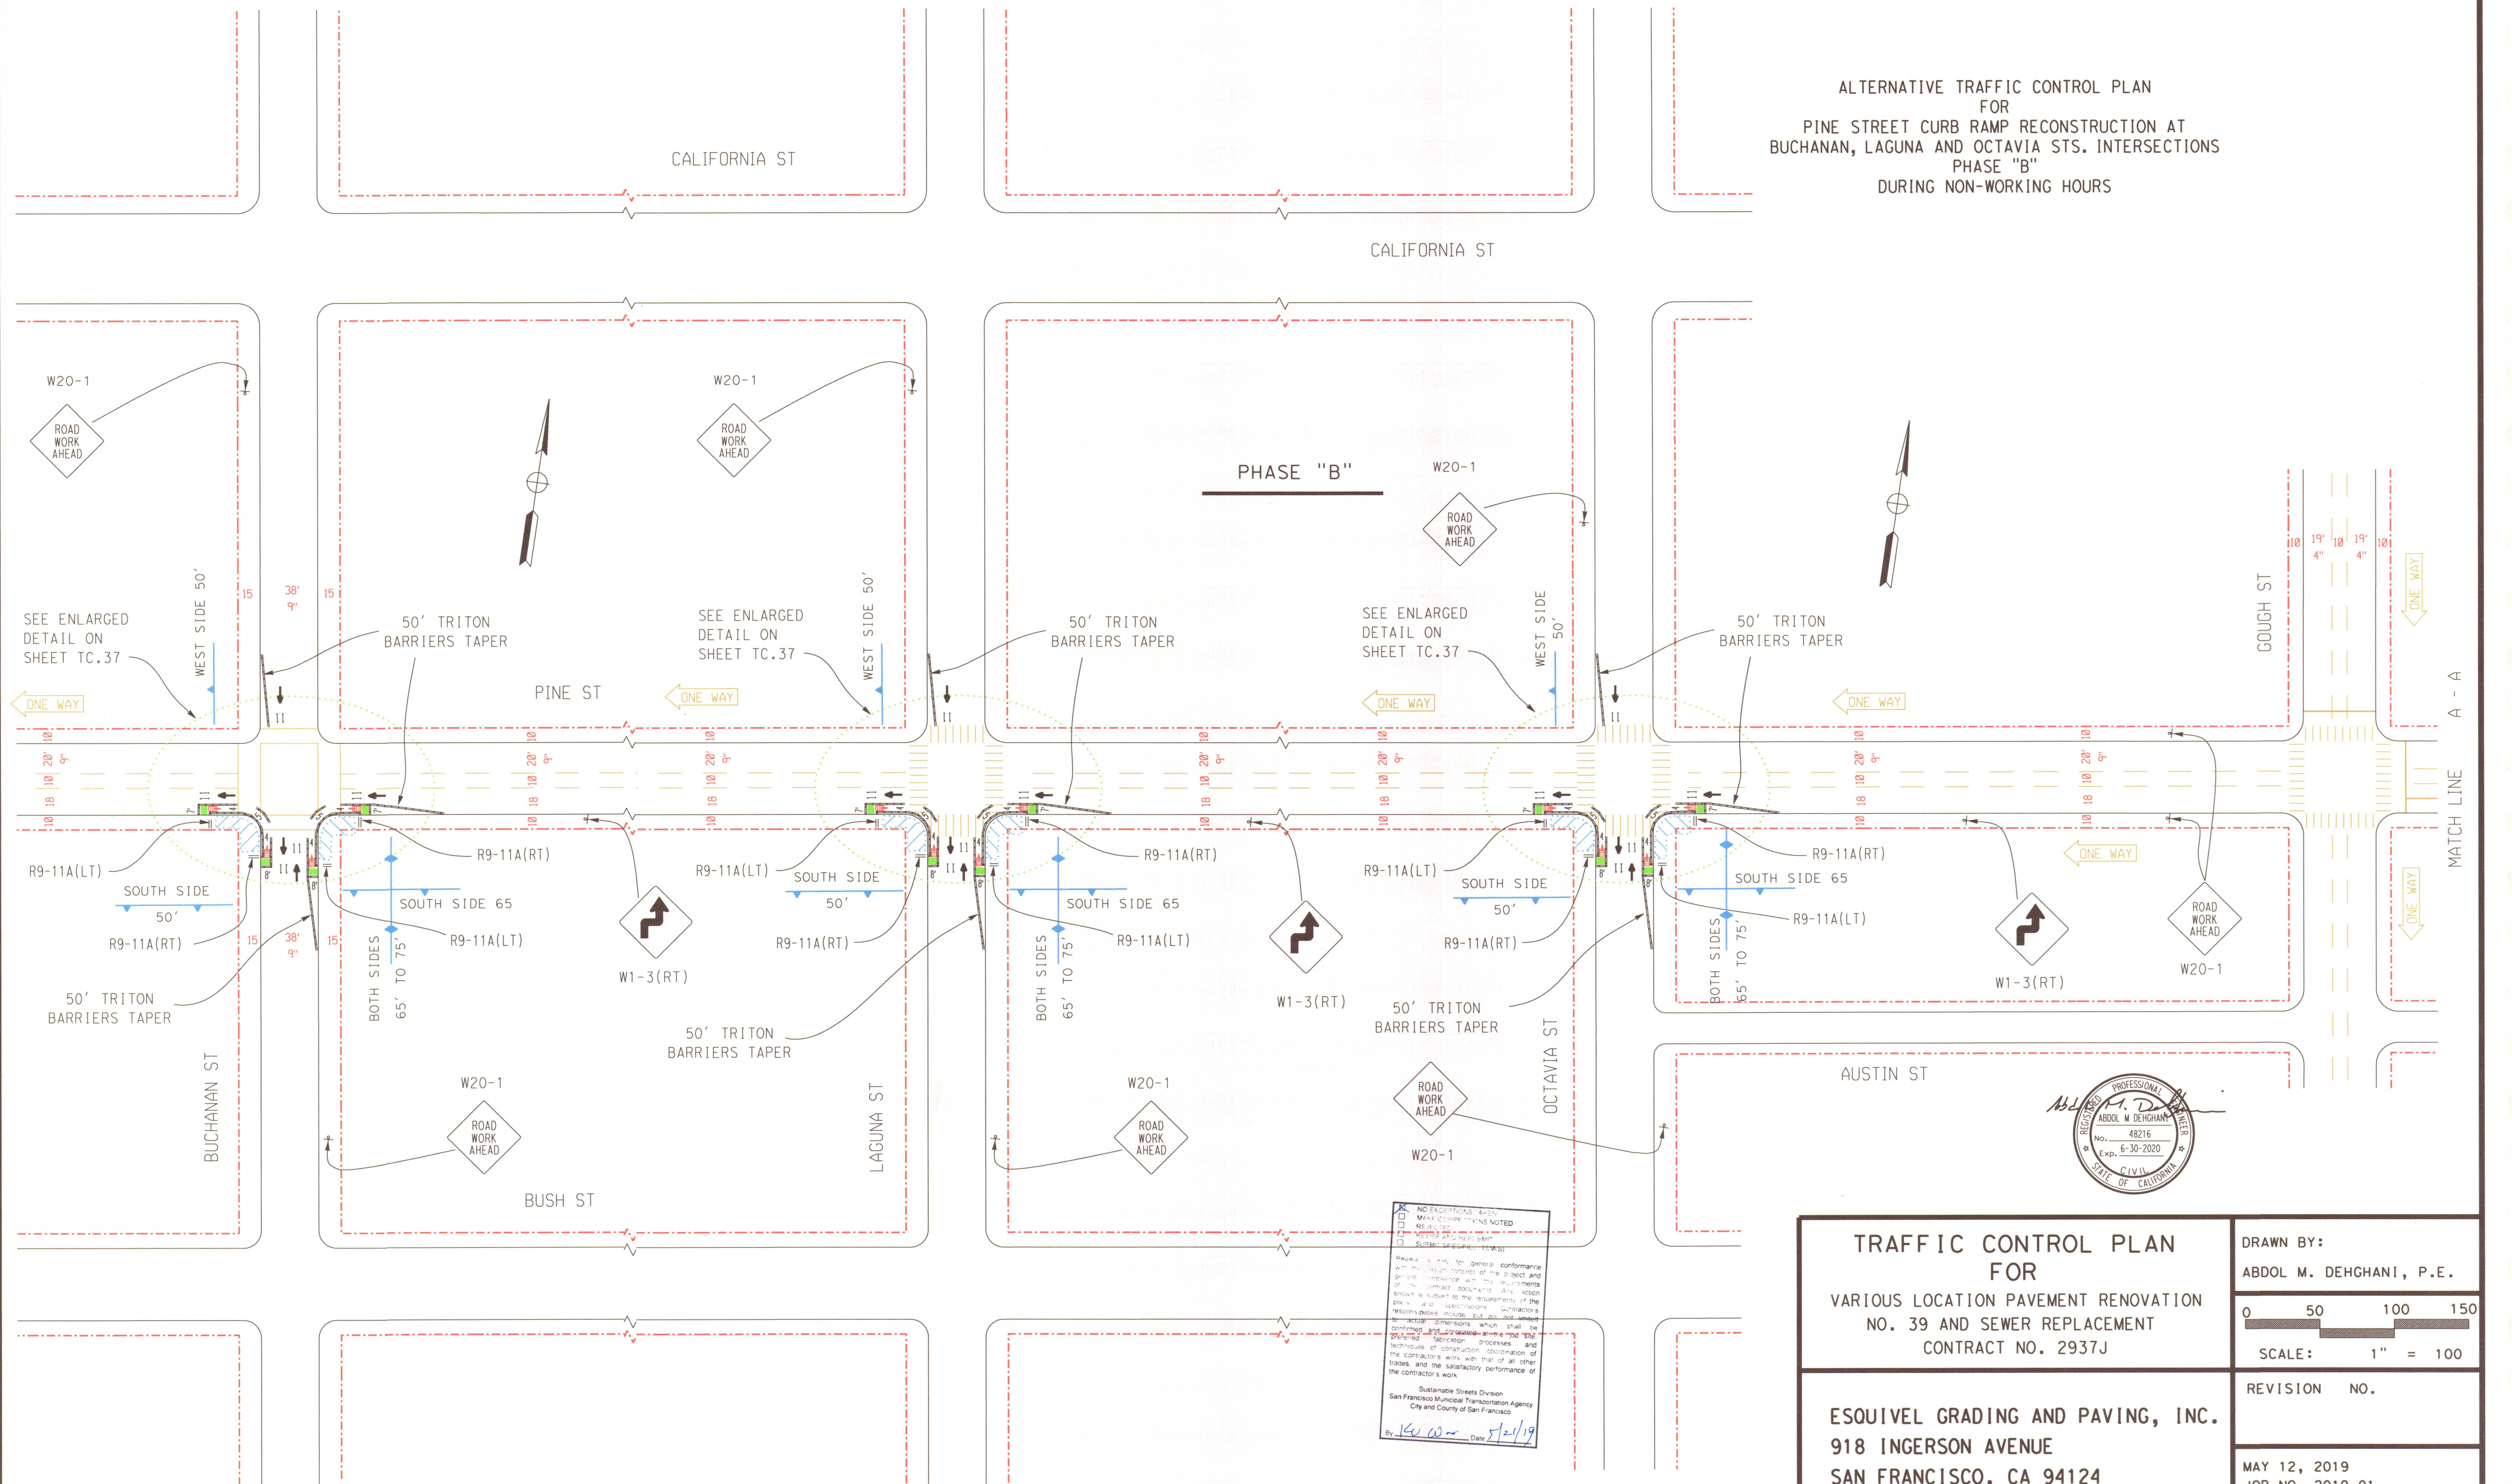

|  |   |
|--|---|
| <b>TRAFFIC CONTROL PLAN<br/>FOR<br/>VARIOUS LOCATION PAVEMENT RENOVATION<br/>NO. 39 AND SEWER REPLACEMENT<br/>CONTRACT NO. 2937J</b> | <b>DRAWN BY:</b><br>ABDOL M. DEHGHANI, P.E.             |
|  | <b>SCALE:</b><br>1" = 100'                              |
| <b>ESQUIVEL GRADING AND PAVING, INC.<br/>918 INGERSON AVENUE<br/>SAN FRANCISCO, CA 94124</b>   | <b>REVISION NO.</b>                                     |
|  | <b>MAY 12, 2019<br/>JOB NO. 2019-01<br/>SHEET TC.41</b> |