

NOTE:

WHEN APPROVE BY THE ENGINEER (RE) CONTRACTOR MAY USE ADA WALL AS AN EQUAL FOR TRITON BARRIERS

CONTRACTOR SHALL NOT BLOCK ACCESS TO ANY DRIVEWAY PROVIDE OPENING ALONG THE CONE LINE AND TRITON BARRIERS TO PROVIDE ACCESS TO ALL DRIVEWAYS

CONTRACTOR MAY WORK AT 3 INTERSECTIONS AT A TIME.

* PLACE W20-1 SIGN 100' (MIN) FROM THE INTERSECTION


PLACE THE WARNING SINGS AT 100' TO 150' FROM EACH OTHER. THE SINGS SHALL NOT BLOCK ANY DRIVEWAY.

1 CONTRACTOR SHALL COORDINATE AND NOTIFY MUNI TO TEMPORARY RELOCATE BUS STOP, (SEE PROJECT SPECIFICATIONS SECTION 01 55 26 3.3) INSTALL TEMP. BUS STOP AS NEEDED.

TRAFFIC CONTROL PLAN
FOR
SACRAMENTO ST. CURB RAMP RECONSTRUCTION
AT LAGUNA AND OCTAVIA STREETS INTERSECTIONS
PHASE "A"
DURING WORKING HOURS

R9-11A(LT)
SIDEWALK CLOSED
CROSS HERE

R9-11A(RT)
SIDEWALK CLOSED
CROSS HERE

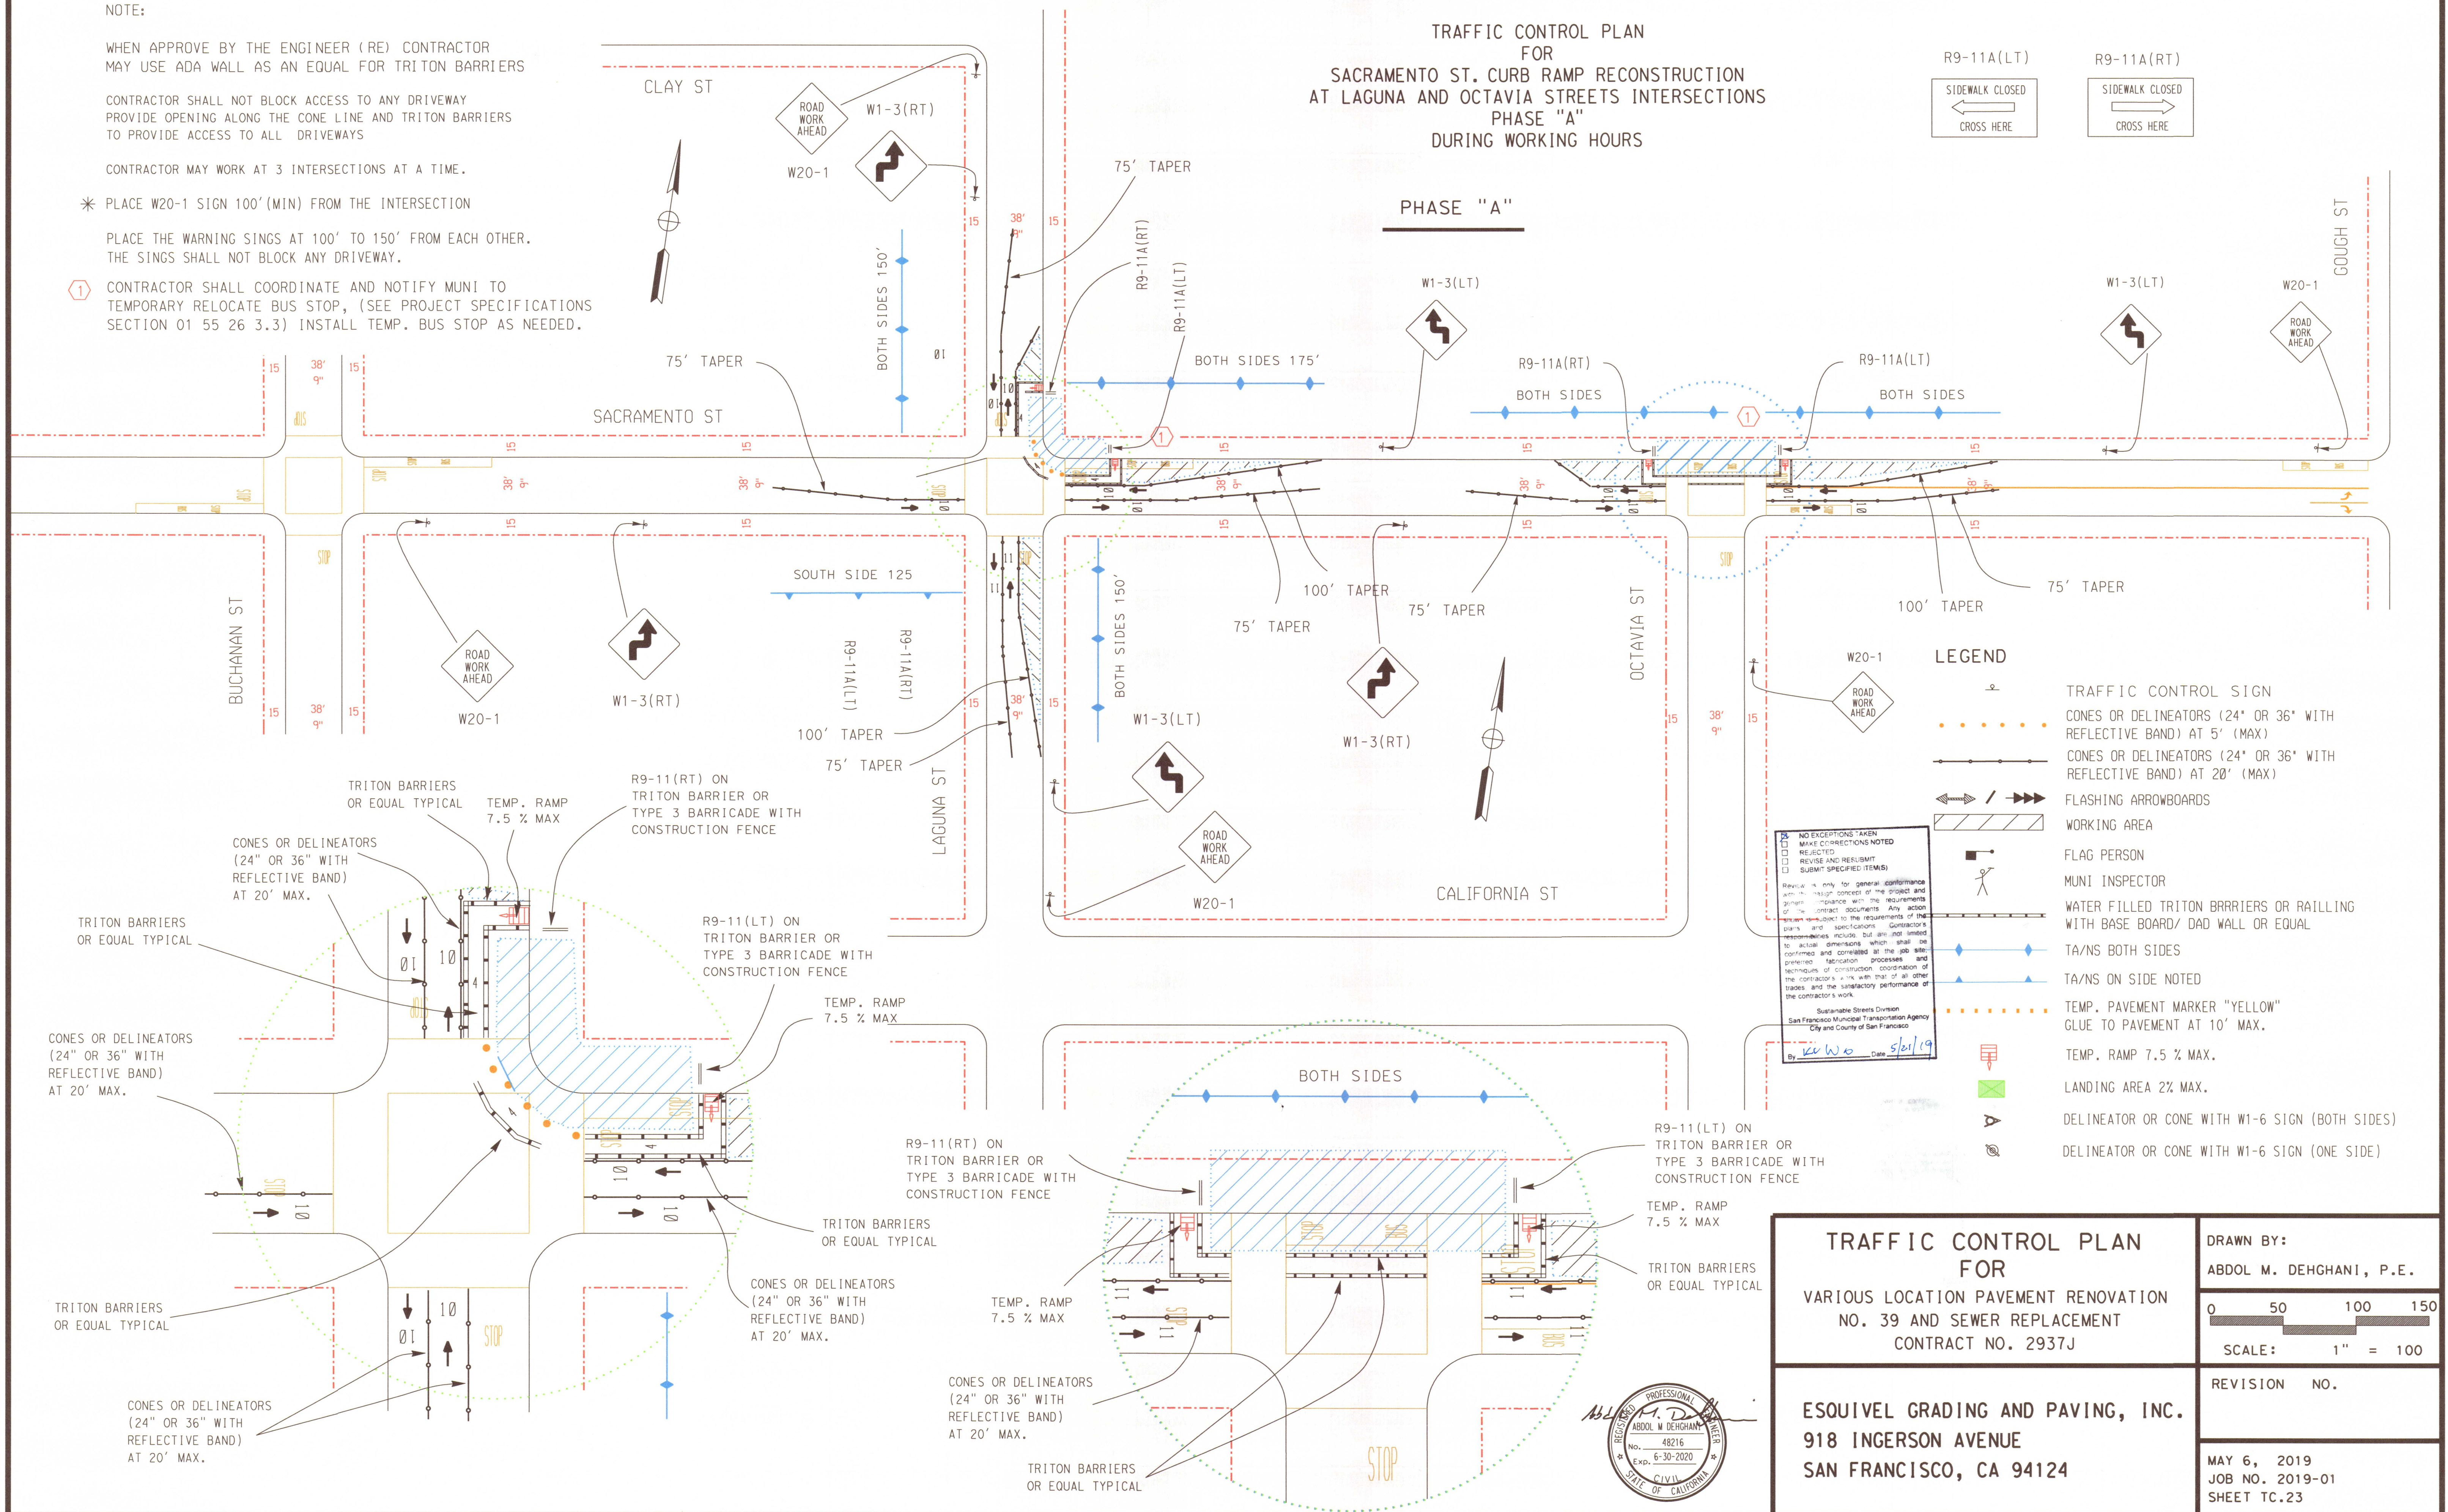

LEGEND

- TRAFFIC CONTROL SIGN
- CONES OR DELINEATORS (24" OR 36" WITH REFLECTIVE BAND) AT 5' (MAX)
- CONES OR DELINEATORS (24" OR 36" WITH REFLECTIVE BAND) AT 20' (MAX)
- FLASHING ARROWBOARDS
- WORKING AREA
- FLAG PERSON
- MUNI INSPECTOR
- WATER FILLED TRITON BARRIERS OR RAILLING WITH BASE BOARD/ DAD WALL OR EQUAL
- TA/NS BOTH SIDES
- TA/NS ON SIDE NOTED
- TEMP. PAVEMENT MARKER "YELLOW" GLUE TO PAVEMENT AT 10' MAX.
- TEMP. RAMP 7.5 % MAX.
- LANDING AREA 2% MAX.
- DELINEATOR OR CONE WITH W1-6 SIGN (BOTH SIDES)
- DELINEATOR OR CONE WITH W1-6 SIGN (ONE SIDE)

NO EXCEPTIONS TAKEN
MAKE CORRECTIONS NOTED
REJECTED
REVISE AND RESUBMIT
SUBMIT SPECIFIC ITEMS

Review is only for general conformance with the design concept of the project and general compliance with the requirements of the contract documents. Any action required is subject to the requirements of the plans and specifications. Contractor's responsibilities include, but are not limited to: field verification of construction, coordination of the contractor's work with that of all other trades, and the satisfactory performance of the contractor's work.

Sustainable Streets Division
San Francisco Municipal Transportation Agency
City and County of San Francisco

By: *[Signature]* Date: 5/21/19

TRAFFIC CONTROL PLAN FOR VARIOUS LOCATION PAVEMENT RENOVATION NO. 39 AND SEWER REPLACEMENT CONTRACT NO. 2937J	DRAWN BY: ABDOL M. DEGHANI, P.E.
	REVISION NO.
ESQUIVEL GRADING AND PAVING, INC. 918 INGERSON AVENUE SAN FRANCISCO, CA 94124	MAY 6, 2019 JOB NO. 2019-01 SHEET TC.23

