
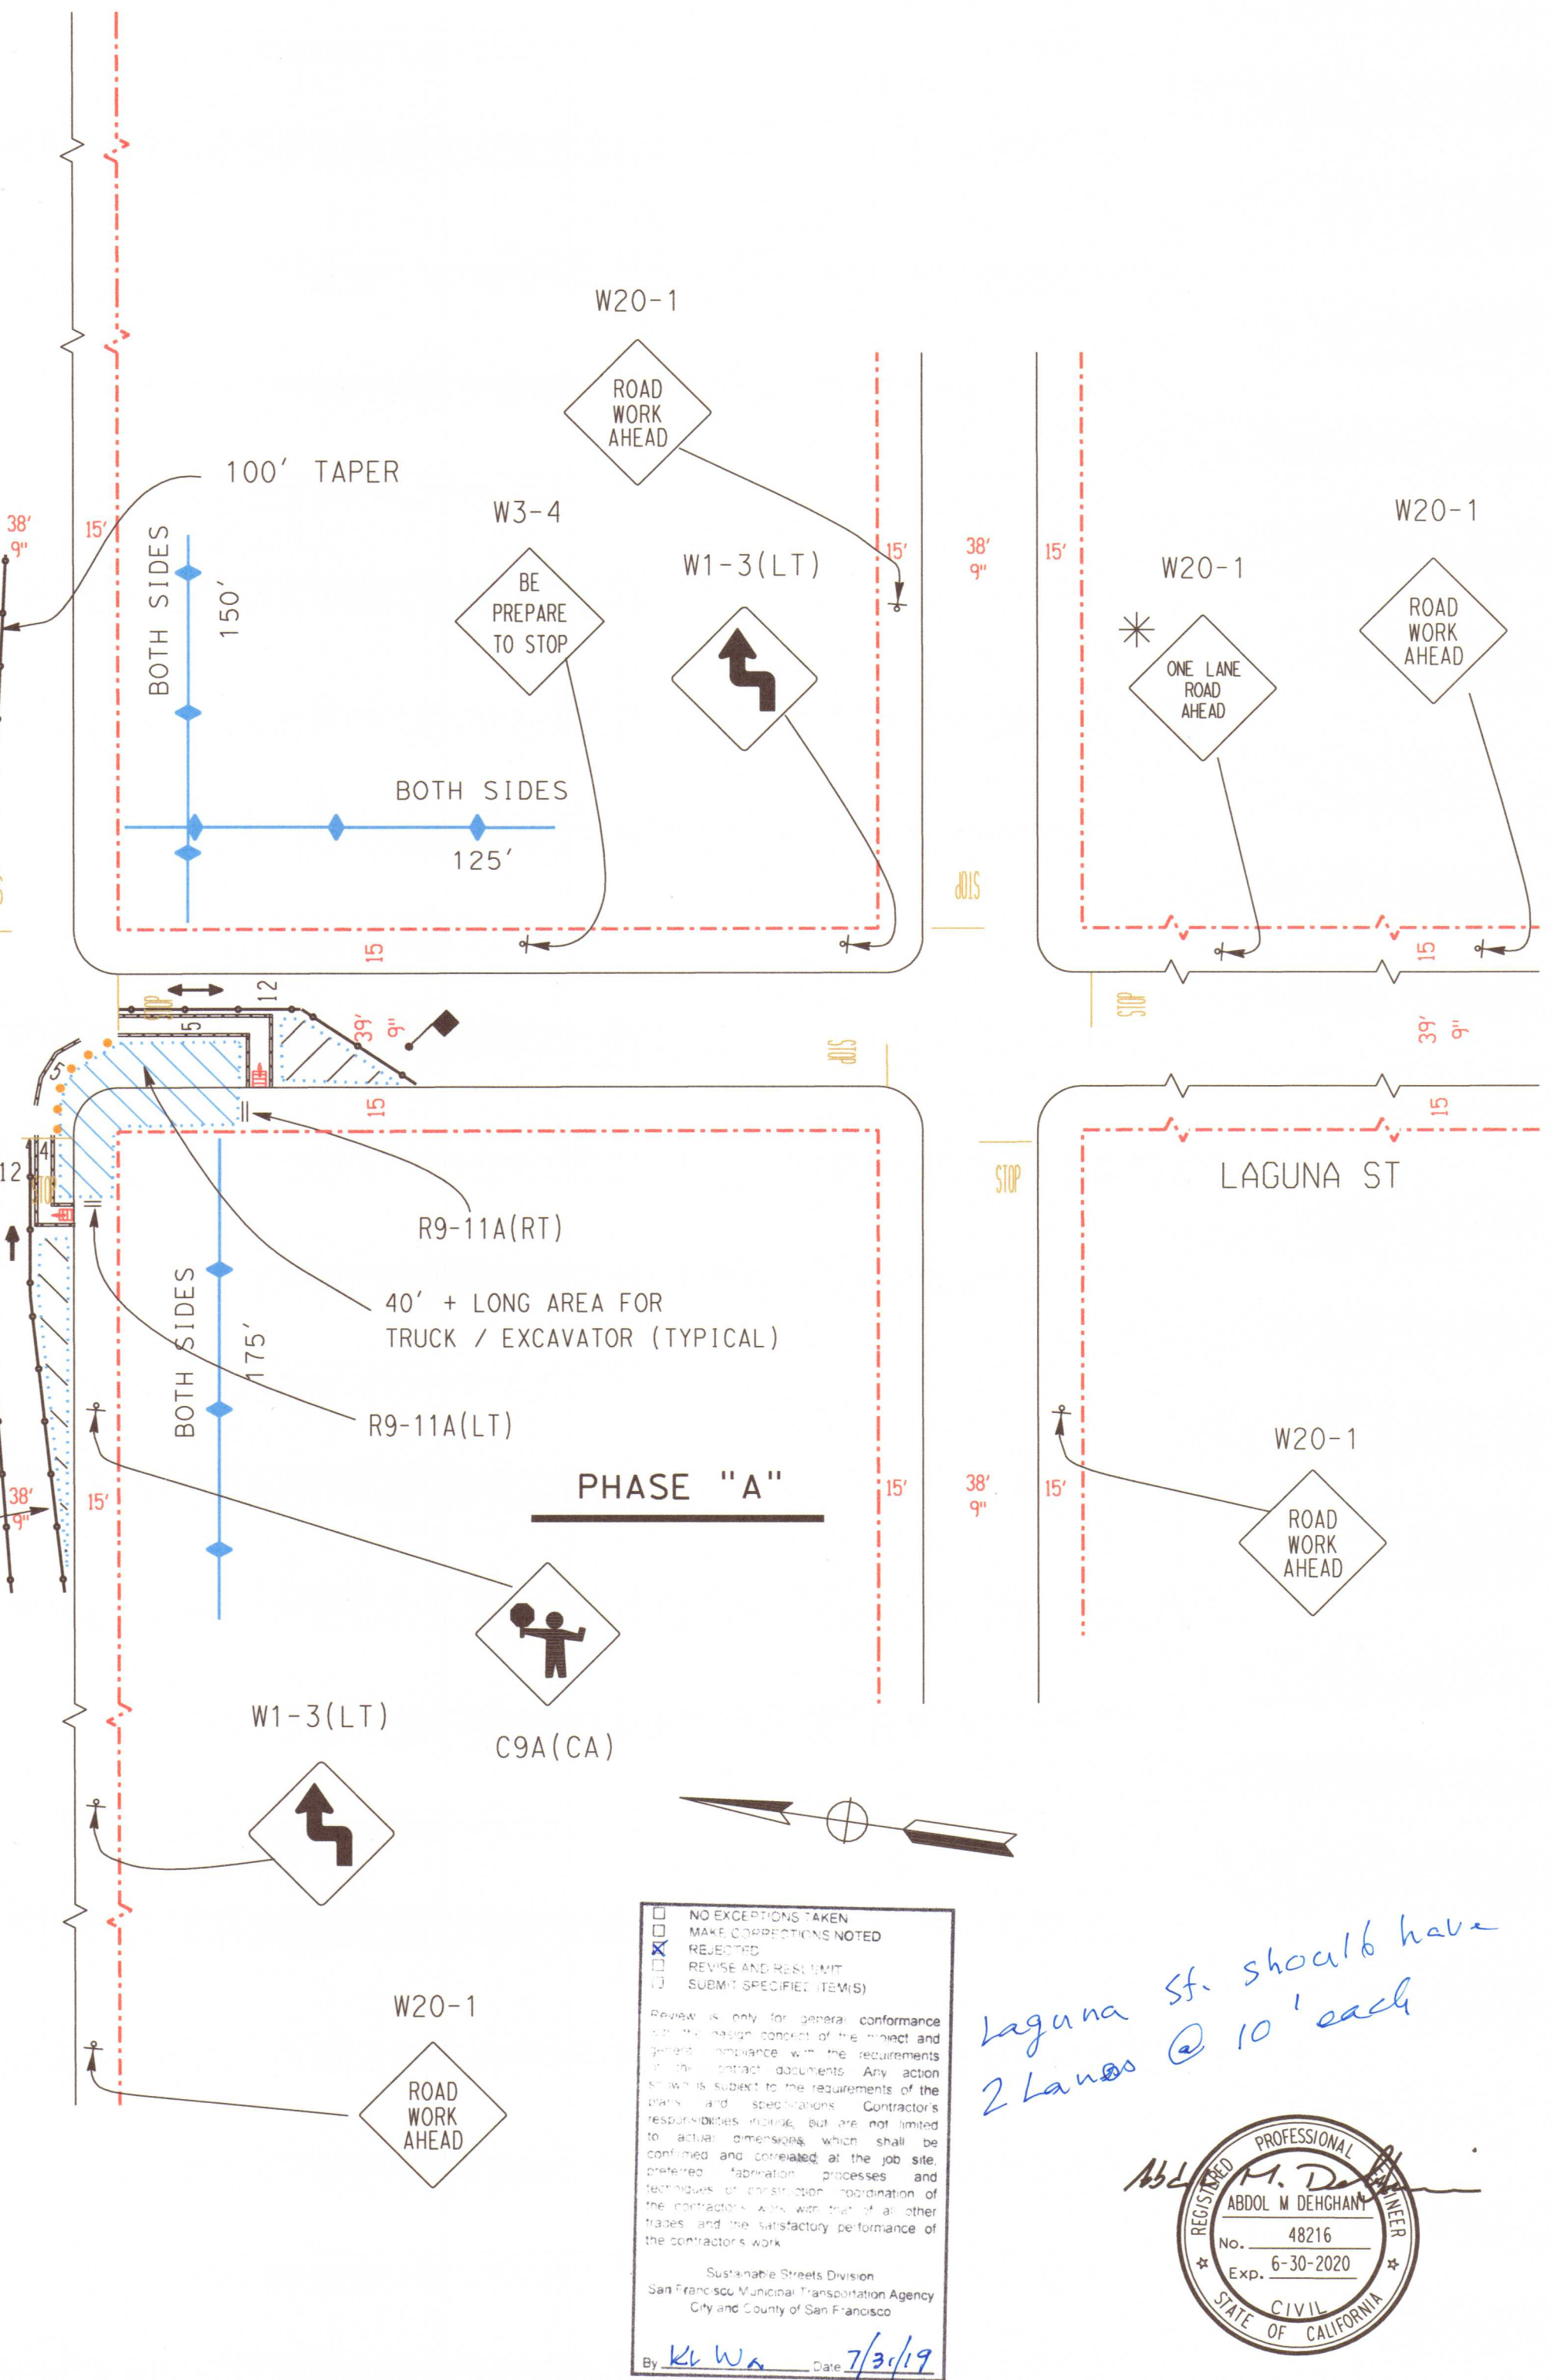


TRAFFIC CONTROL PLAN
FOR
LAGUNA ST. CURB RAMP RECONSTRUCTION
AT LAGUNA AND JACKSON STREETS INTERSECTIONS
PHASE "A" AND "B"
DURING WORKING HOURS

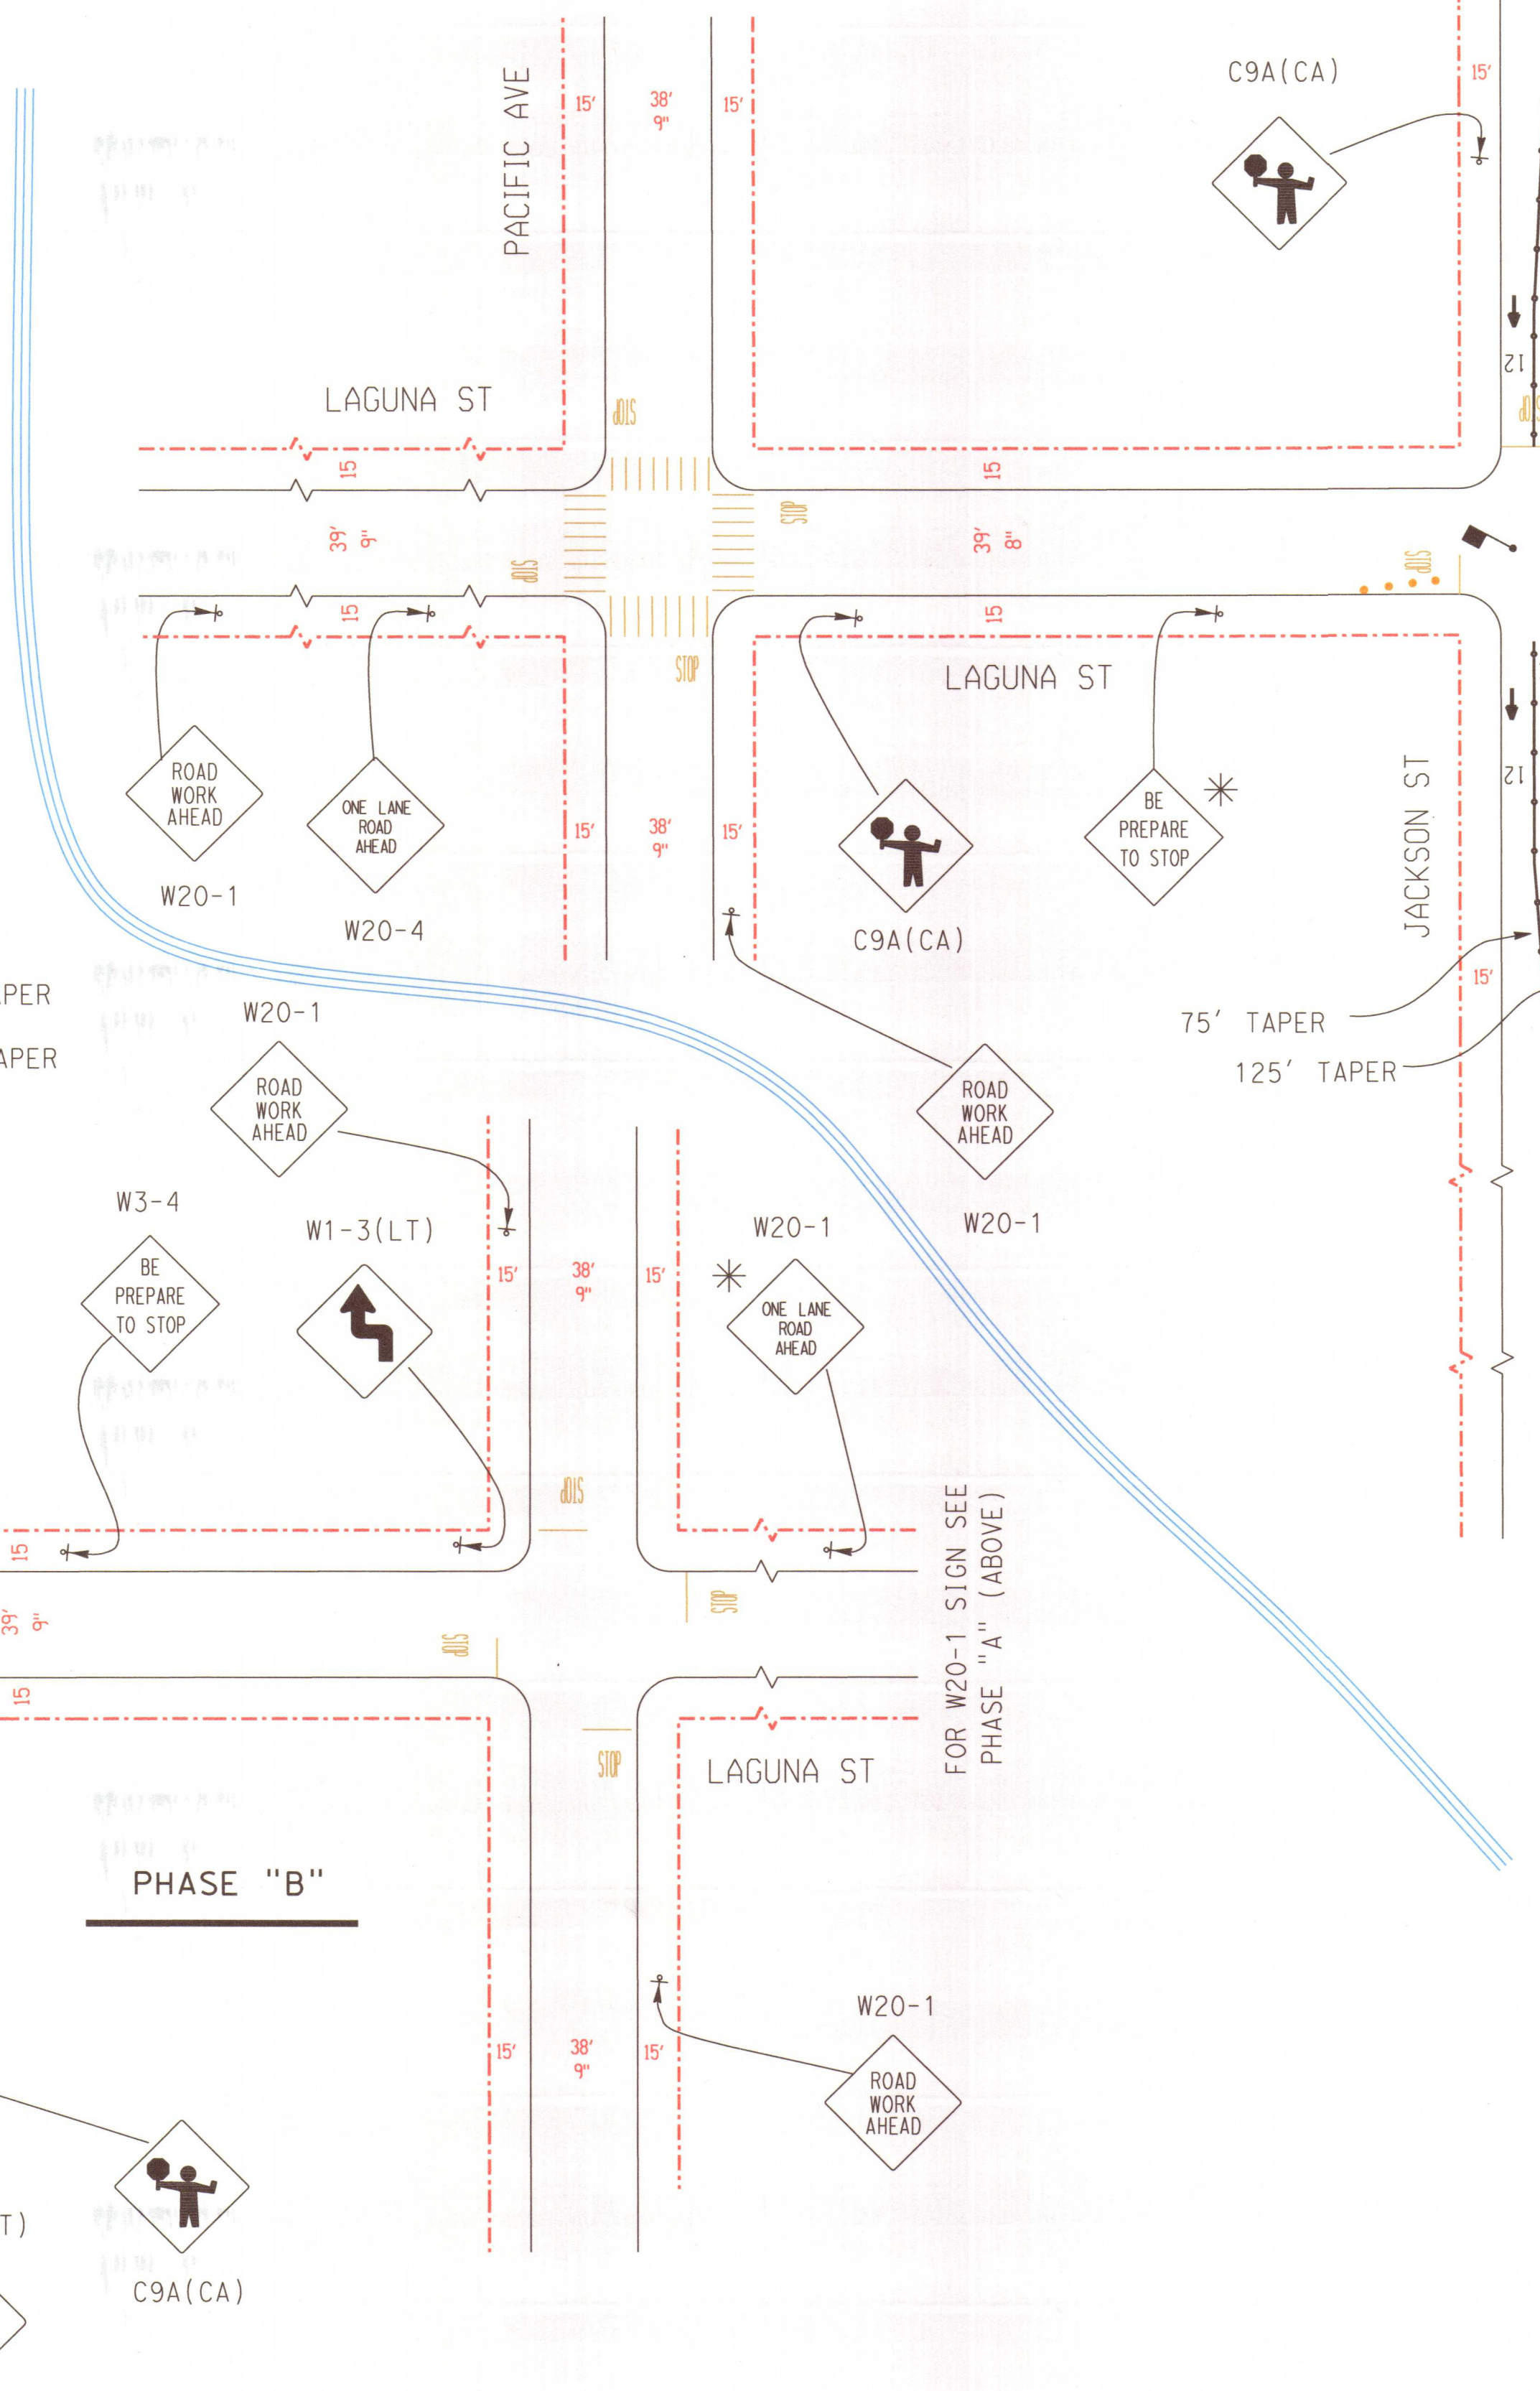

FOR W20-1 SIGN SEE PHASE "A" (ABOVE)


FOR W20-1 SIGN SEE PHASE "A" (ABOVE)


FOR W20-1 SIGN SEE PHASE "A" (ABOVE)

FOR W20-1 SIGN SEE PHASE "A" (ABOVE)

NO EXCEPTIONS TAKEN
MAKE CORRECTIONS NOTED
REVIEWED
SUBMIT SPECIFIC TO MS
Reviewed is only for general performance
and does not constitute an endorsement
or approval of the project or the
contractor's work. Any action
taken by the City is subject to the requirements of the
San Francisco Municipal Transportation Agency
and the County of San Francisco.
Sustainable Streets Division
San Francisco Municipal Transportation Agency
City and County of San Francisco
By: *KW* Date: *7/3/19*

*Laguna St. should have
2 lanes @ 10' each*

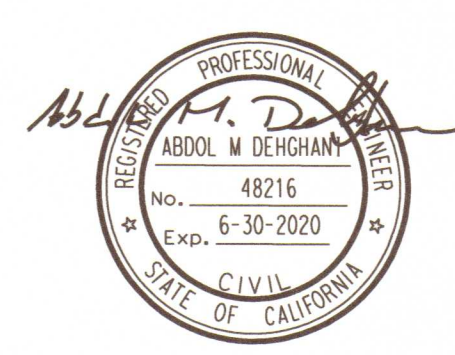

TRAFFIC CONTROL PLAN FOR VARIOUS LOCATION PAVEMENT RENOVATION NO. 39 AND SEWER REPLACEMENT CONTRACT NO. 2937J	DRAWN BY: ABDOL M. DEGHANI, P.E.
	0 50 100 150  SCALE: 1" = 100
ESQUIVEL GRADING AND PAVING, INC. 918 INGERSON AVENUE SAN FRANCISCO, CA 94124	REVISION NO. 1 JULY 25, 2019 July 15, 2019 JOB NO. 2019-01 SHEET TC.87- REVISED