


TRAFFIC CONTROL PLAN
FOR
LINE EXISTING 3'X5' BRICK SEWER AT
LAGUNA ST. FROM LOMBARD TO GREENWICH STREETS

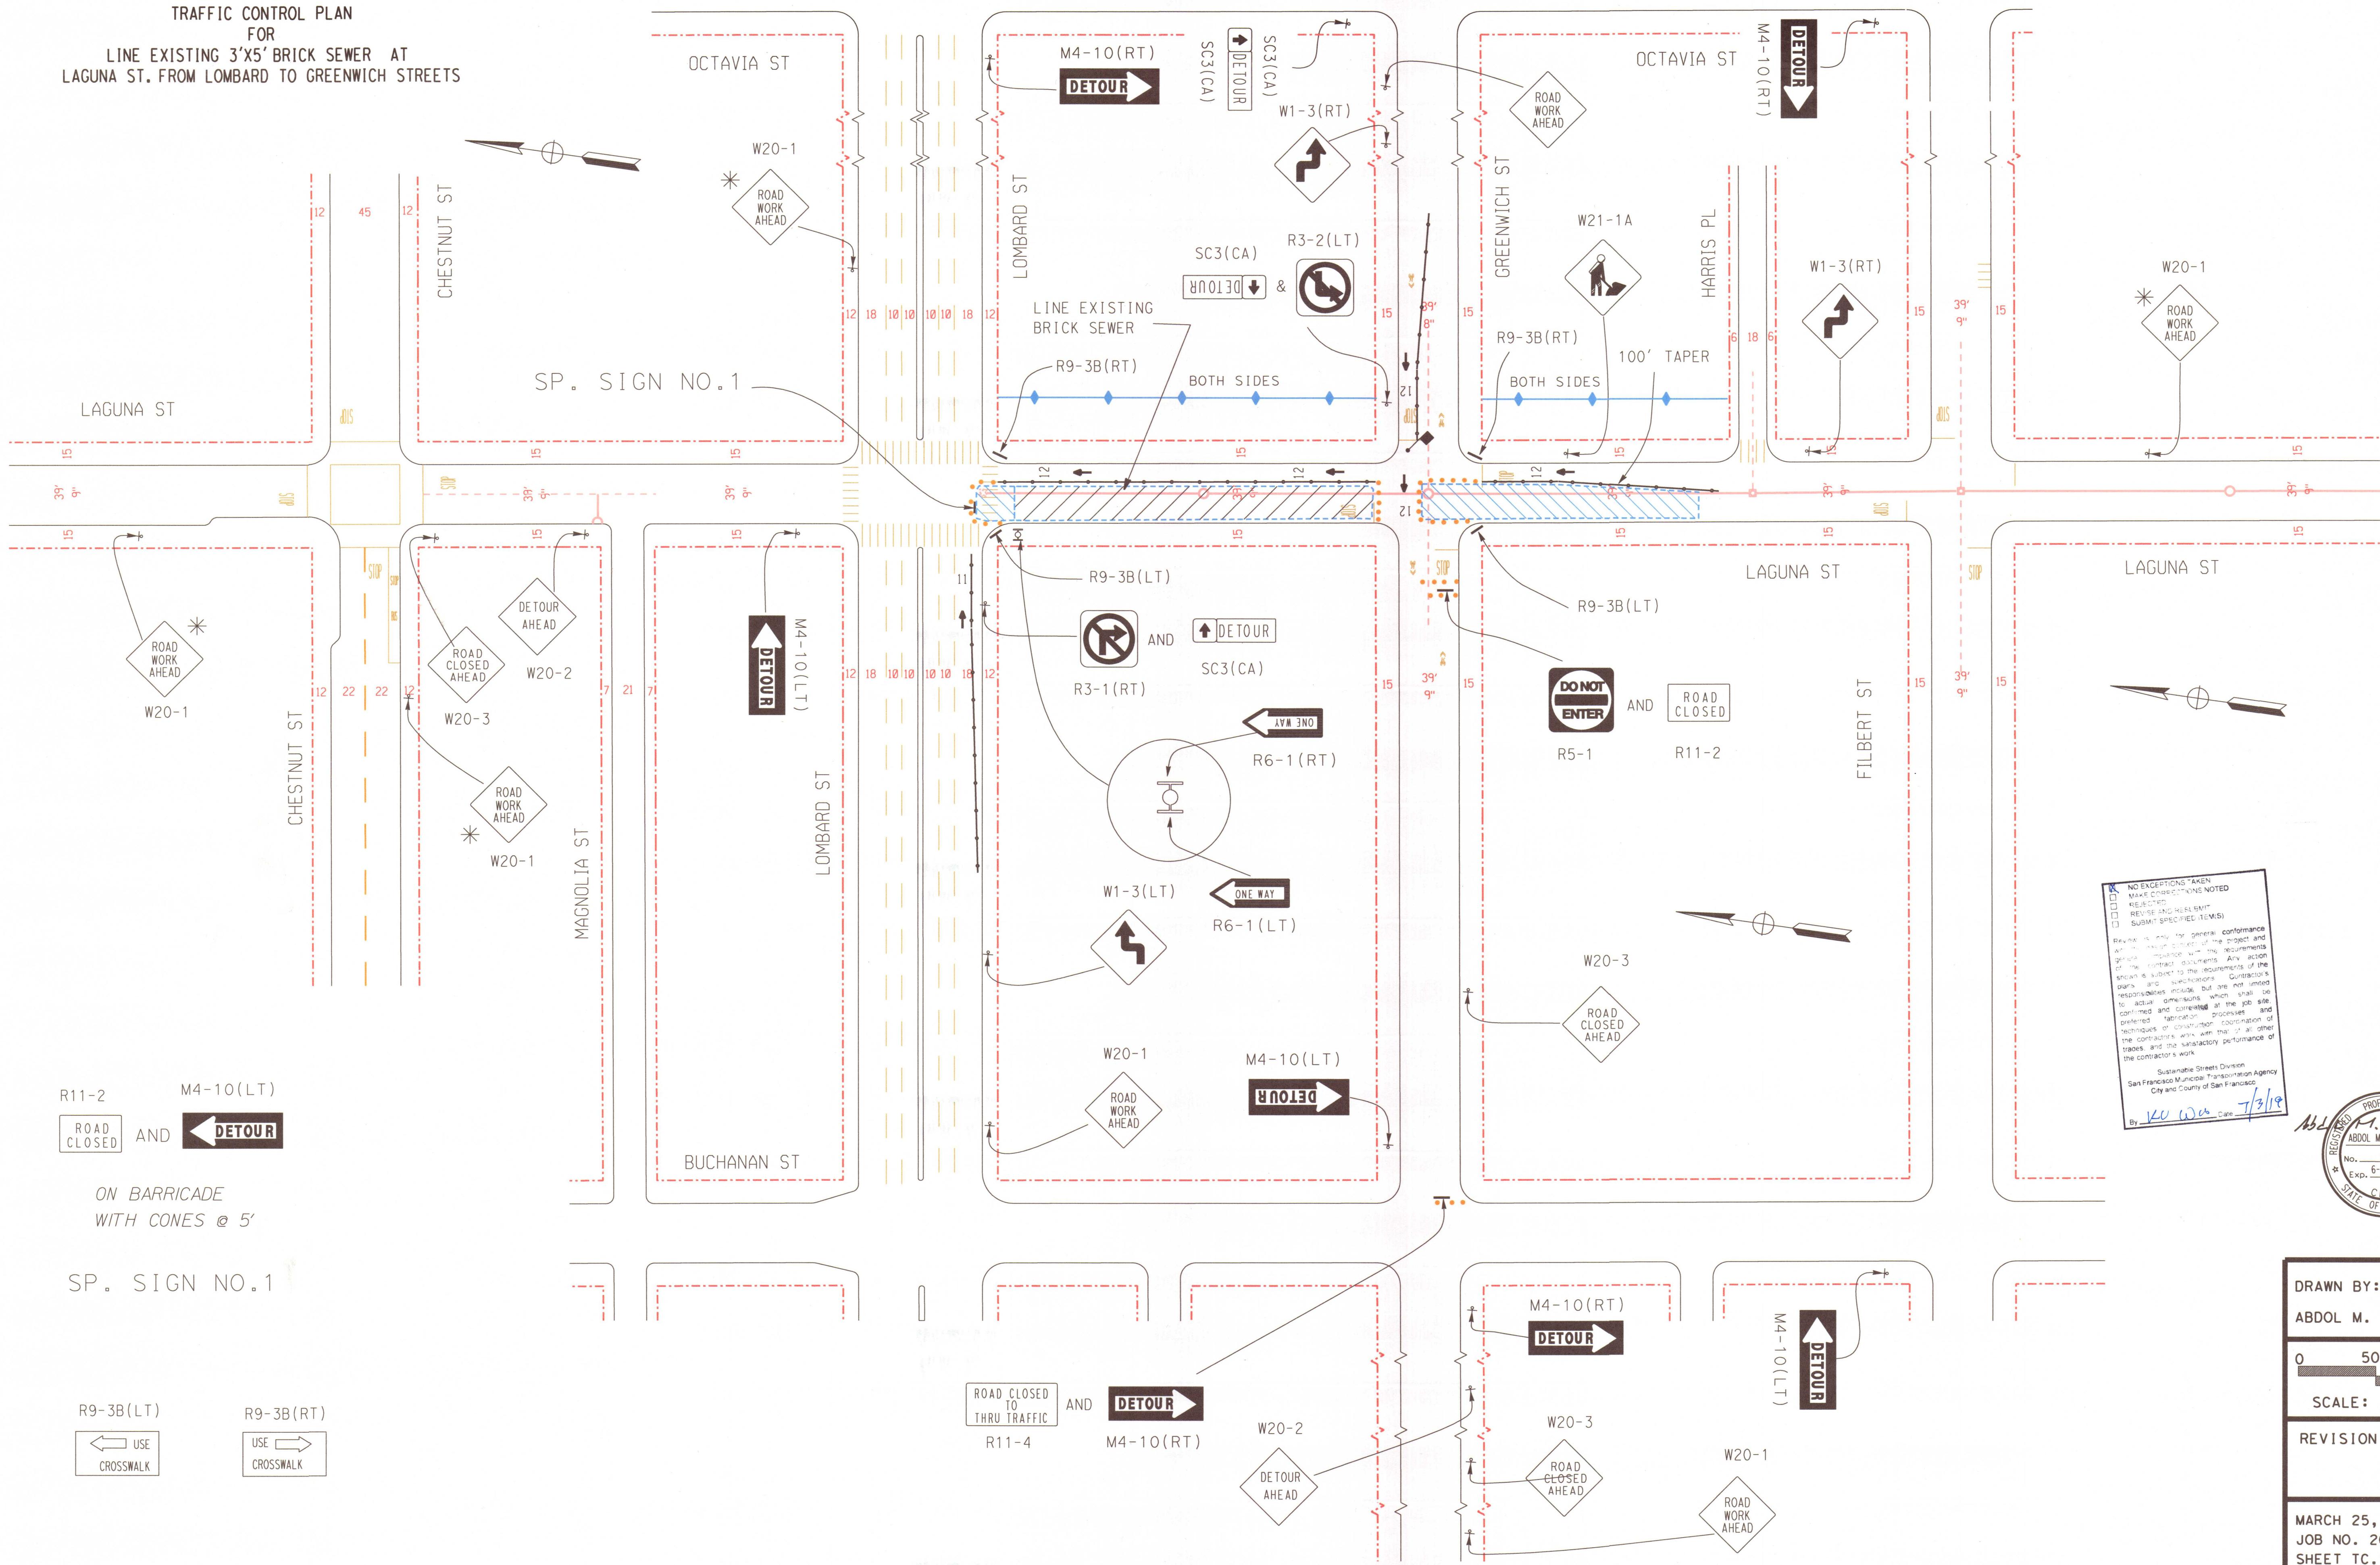


NO EXCEPTIONS TAKEN
NAME CORRECTIONS NOTED
REVIEWED AND RE-DESIGNED
SUBMIT SPECIFIED ITEMS

Reviewed for general conformance
and compliance with the requirements
of the contract documents. Any action
of the contractor is subject to the requirements of the
plans and specifications. Contractor's
responsibilities include, but are not limited to:
to actual dimensions which shall be
confirmed and controlled at the job site;
preferred fabrication processes and
techniques of construction; coordination of
the contractor's work with that of all other
trades; and the satisfactory performance of
the contractor's work.

Sustainable Streets Division
San Francisco Municipal Transportation Agency
City and County of San Francisco

By: *[Signature]* Date: 7/3/19

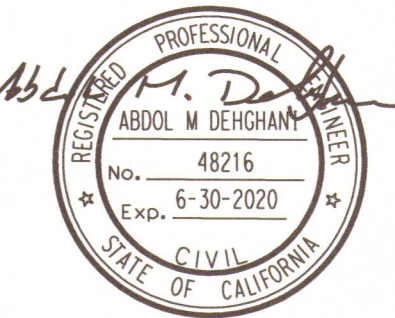

DRAWN BY:	
ABDOL M. DEGHANI, P.E.	
0 50 100 150	
SCALE: 1" = 100	
REVISION	NO.
MARCH 25, 2019	
JOB NO. 2019-01	
SHEET TC.13 - ALTERNATIVE	