


TRAFFIC CONTROL PLAN  
FOR  
LAGUNA STREET CONCRETE PAVEMENT RECONSTRUCTION AT  
EAST SIDE OF LAGUNA ST. FROM PACIFIC AVE. TO JACTON STREET  
PHASE "B"  
DURING WORKING HOURS

PHASE "B"  
DURING NON - WORKING HOURS

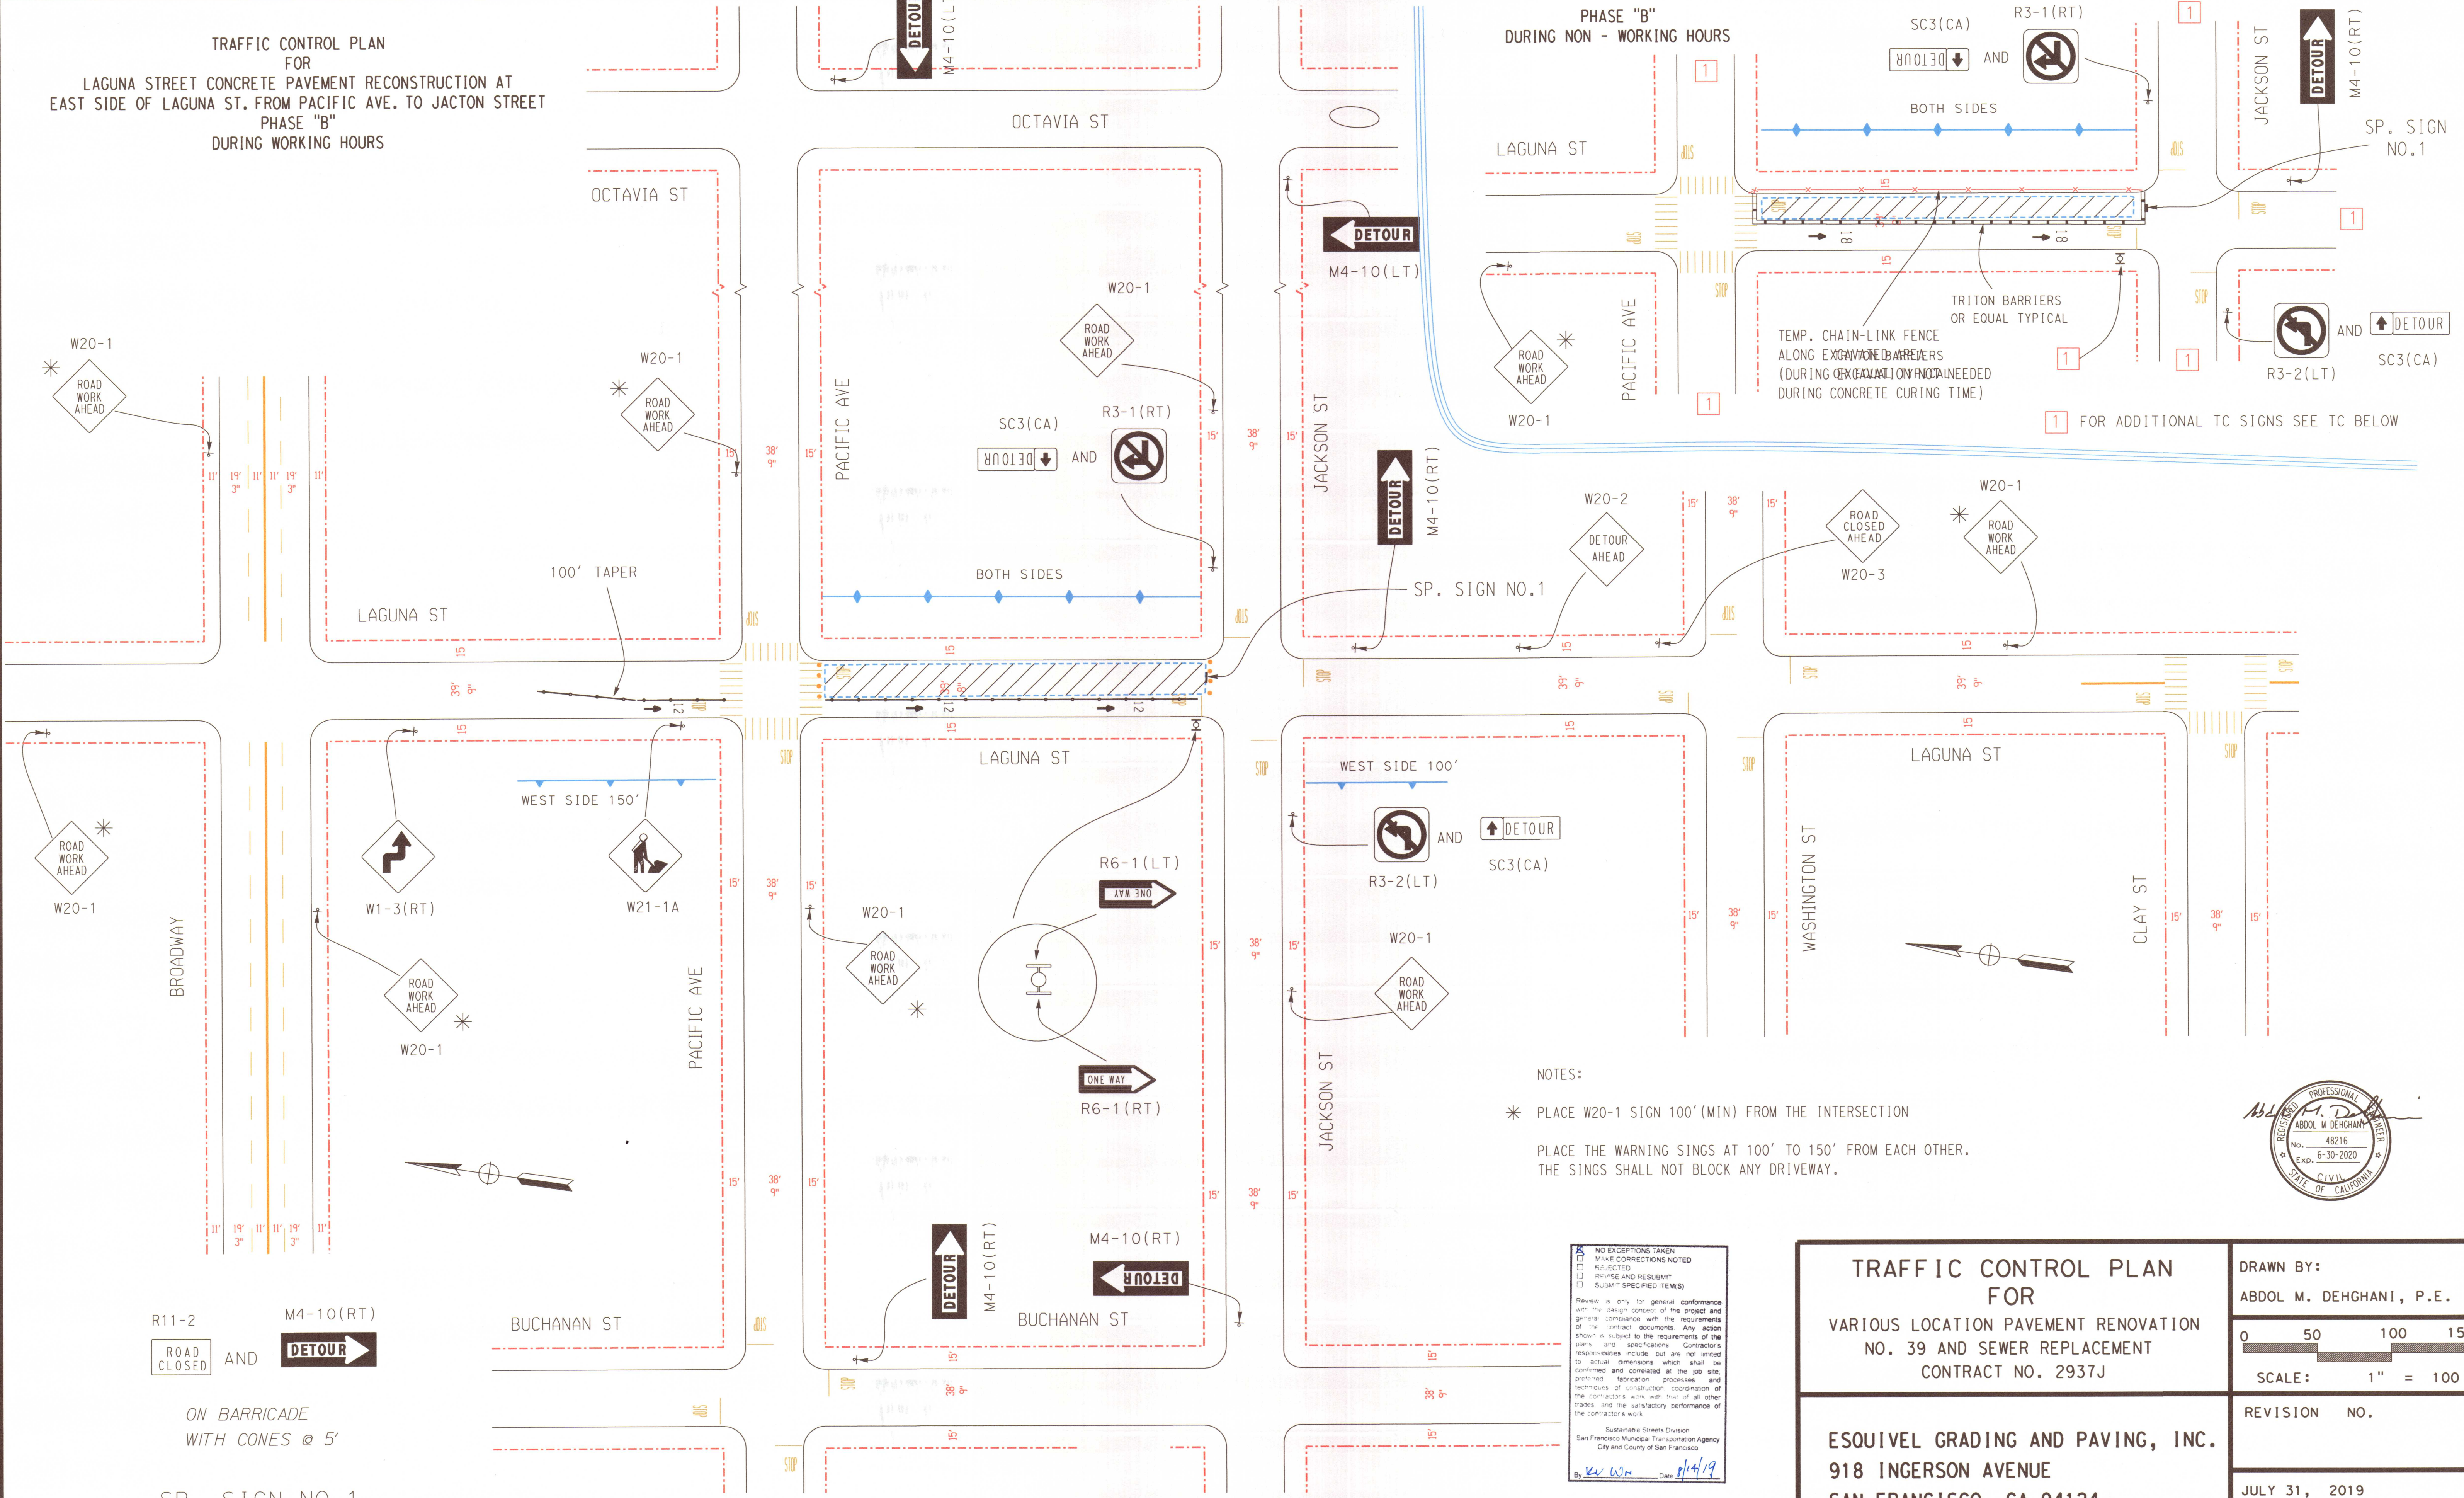

NOTES:

\* PLACE W20-1 SIGN 100' (MIN) FROM THE INTERSECTION

PLACE THE WARNING SINGS AT 100' TO 150' FROM EACH OTHER.  
THE SINGS SHALL NOT BLOCK ANY DRIVEWAY.

NO EXCEPTIONS TAKEN  
MAKE CORRECTIONS NOTED  
REJECTED  
REVISE AND RESUBMIT  
SUBMIT SPECIFIED ITEM(S)  
Review is only for general conformance  
with the design concept of the project and  
general compliance with the requirements  
of the contract documents. Any action  
shown is subject to the requirements of the  
plans and specifications. Contractors  
responsibilities include, but are not limited  
to actual dimensions which shall be  
confirmed and correlated at the job site.  
preferred fabrication processes and  
techniques of construction, coordination of  
the contractors with with that of all other  
trades and the satisfactory performance of  
the contractors work.  
Sustainable Streets Division  
San Francisco Municipal Transportation Agency  
City and County of San Francisco  
By: *kw* Date: *8/14/19*

TRAFFIC CONTROL PLAN  
FOR  
VARIOUS LOCATION PAVEMENT RENOVATION  
NO. 39 AND SEWER REPLACEMENT  
CONTRACT NO. 2937J

ESQUIVEL GRADING AND PAVING, INC.  
918 INGERSON AVENUE  
SAN FRANCISCO, CA 94124

DRAWN BY:  
ABDOL M. DEGHANI, P.E.  
0 50 100 150  
SCALE: 1" = 100  
REVISION NO.  
JULY 31, 2019  
JOB NO. 2019-01  
SHEET TC.95

