


TRAFFIC CONTROL PLAN
FOR
LAGUNA ST. CURB RAMP RECONSTRUCTION
AT LAGUNA AND JACKSON STREETS INTERSECTIONS
PHASE "A" AND "B"
DURING NON-WORKING HOURS

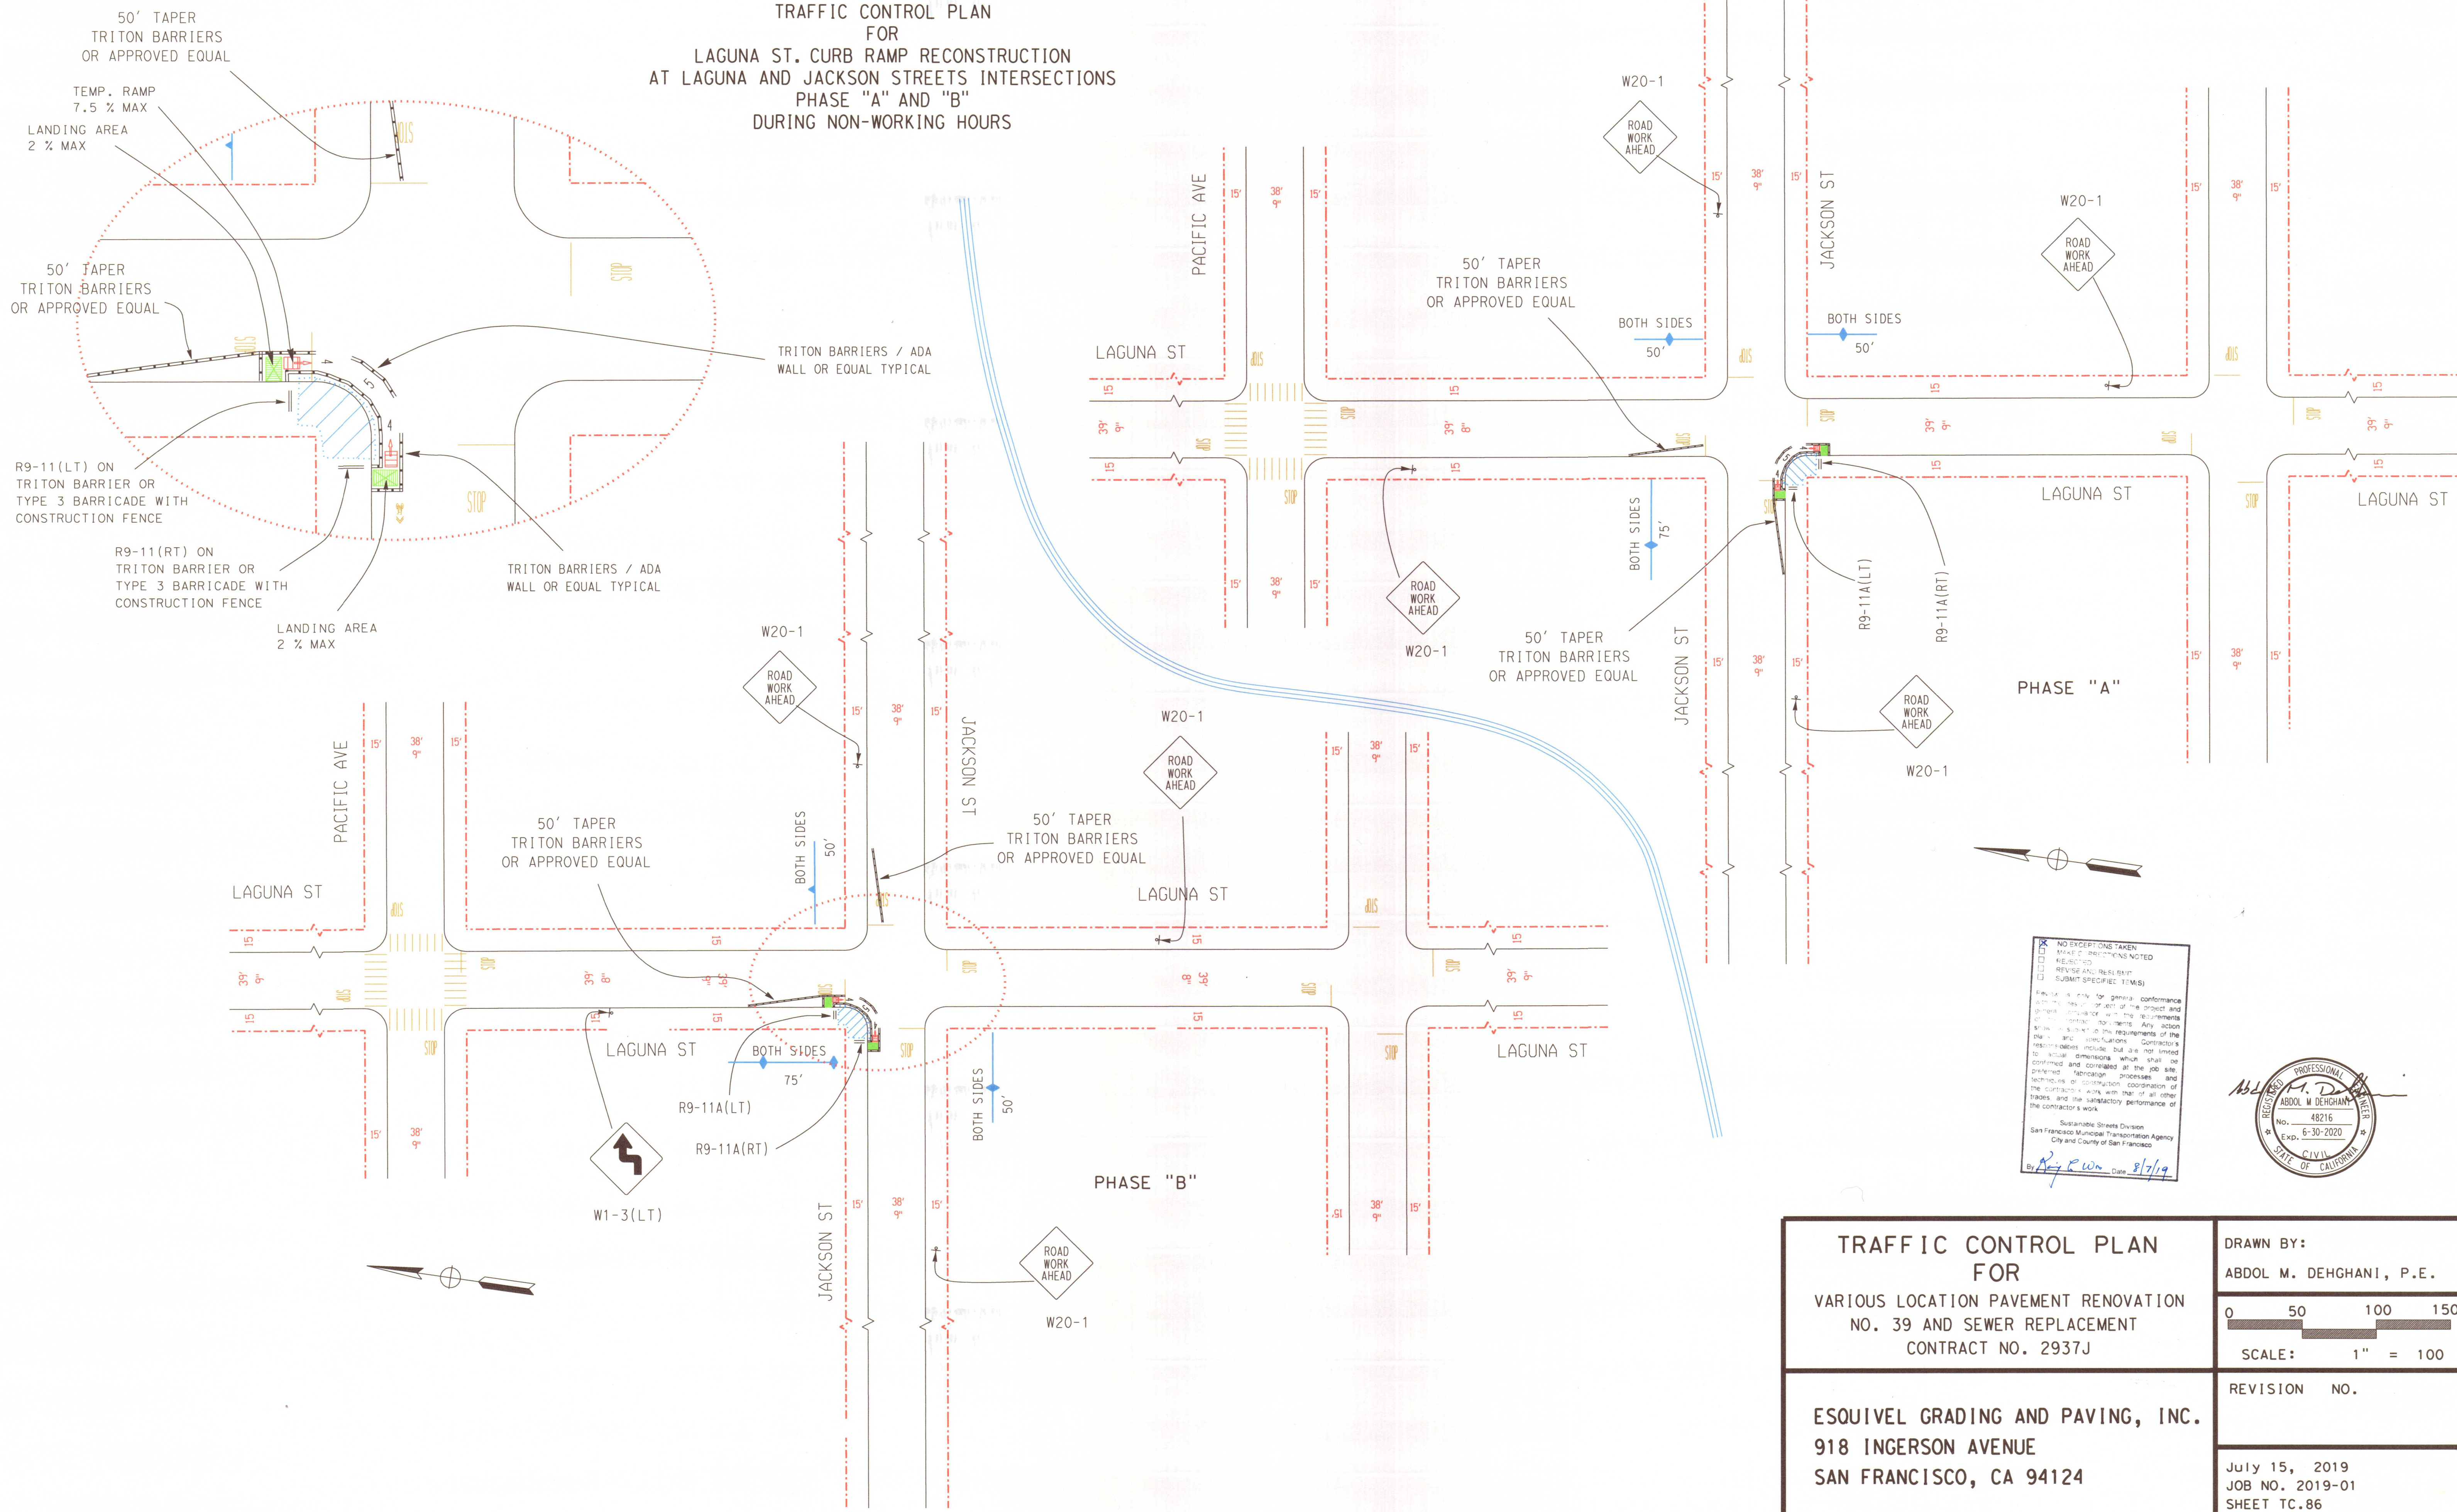


NO EXCEPTIONS TAKEN
MAKE CORRECTIONS NOTED
REVISOR
REVISED RESUBMIT
SUBMIT SPECIFIC ITEMS

Revised is only for general conformance with the project and the requirements of the project. Any action taken and specifications of the contractor's work shall be confirmed and coordinated at the job site. Techniques of construction, coordination of trades, and the satisfactory performance of the contractor's work.

Sustainable Streets Division
San Francisco Municipal Transportation Agency
City and County of San Francisco

By: *[Signature]* Date: 8/7/19

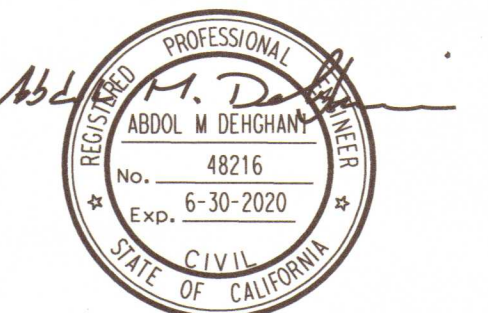

TRAFFIC CONTROL PLAN FOR VARIOUS LOCATION PAVEMENT RENOVATION NO. 39 AND SEWER REPLACEMENT CONTRACT NO. 2937J	DRAWN BY: ABDOL M. DEGHANI, P.E.
	0 50 100 150 SCALE: 1" = 100
ESQUIVEL GRADING AND PAVING, INC. 918 INGERSON AVENUE SAN FRANCISCO, CA 94124	REVISION NO.
	July 15, 2019 JOB NO. 2019-01 SHEET TC.86