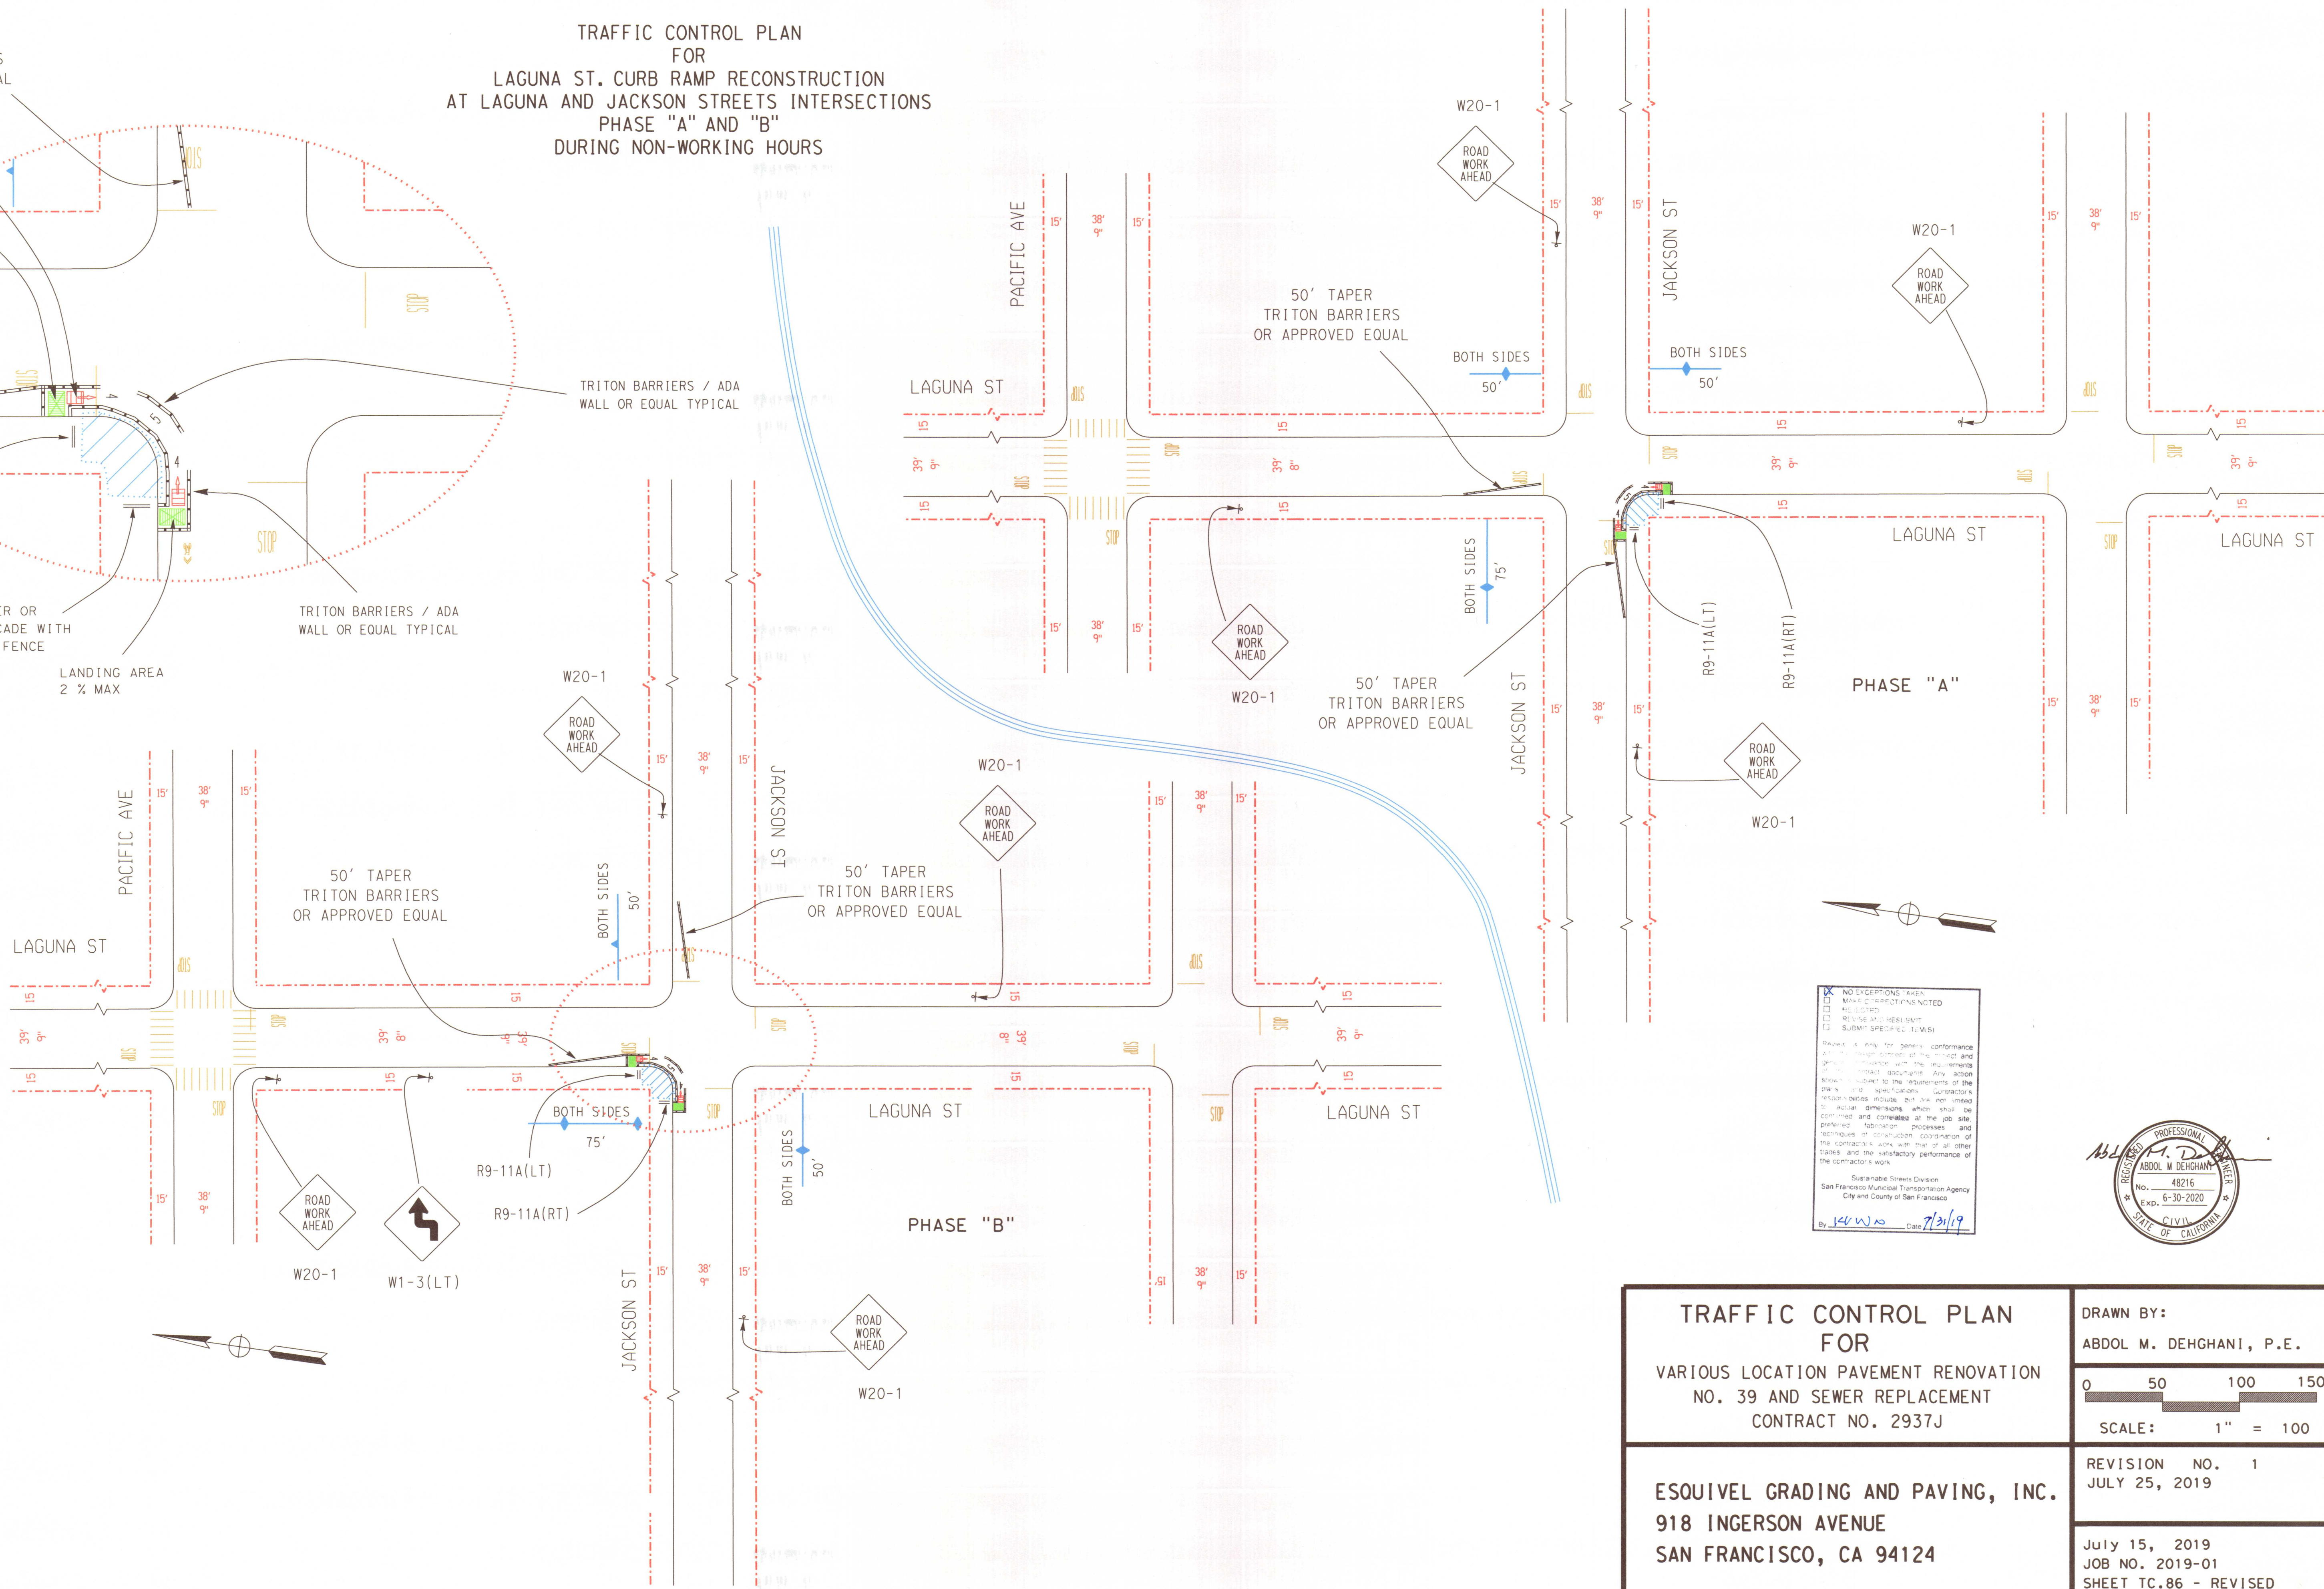


[illegible]


☒ NO EXCEPTIONS TAKEN  
☐ MAJOR EXCEPTIONS NOTED  
☐ MINOR  
☐ REVISE AND RESUBMIT  
☐ SUBMIT SPECIFIED T.E.M.S.

Review is only for general performance and to assign contract of the project and general compliance with the requirements of the contract documents. Any action shown is subject to the requirements of the plans and specifications. Contractor's ~~responsibilities~~ include that they are not limited to actual construction. They shall be confirmed and include all the job site prepared fabrication processes and techniques of construction combination of the contractor's work with that of all other trades and the satisfactory performance of the contractor's work.

Sustainable Streets Division  
San Francisco Municipal Transportation Agency  
City and County of San Francisco

By JCW Date 7/31/19



<h2 style="margin: 0;">TRAFFIC CONTROL PLAN FOR</h2> <h3 style="margin: 0;">VARIOUS LOCATION PAVEMENT RENOVATION NO. 39 AND SEWER REPLACEMENT CONTRACT NO. 2937J</h3>	<p><b>DRAWN BY:</b> ABDOL M. DEGHANI, P.E.</p> <div style="border: 1px solid black; padding: 5px; margin-top: 10px;">  </div> <p><b>SCALE:</b> 1" = 100'</p>
<p><b>ESQUIVEL GRADING AND PAVING, INC.</b> 918 INGERSON AVENUE SAN FRANCISCO, CA 94124</p>	<p><b>REVISION NO. 1</b> JULY 25, 2019</p> <hr/> <p>July 15, 2019 JOB NO. 2019-01 SHEET TC.86 - REVISED</p>