


TRAFFIC CONTROL PLAN
FOR
LAGUNA STREET SEWER REPLACEMENT AND
WEST SIDE SEWER LATERAL CONNECTION/REPLACEMENT AT
LAGUNA ST. FROM JACTON TO WASHINGTON STREET

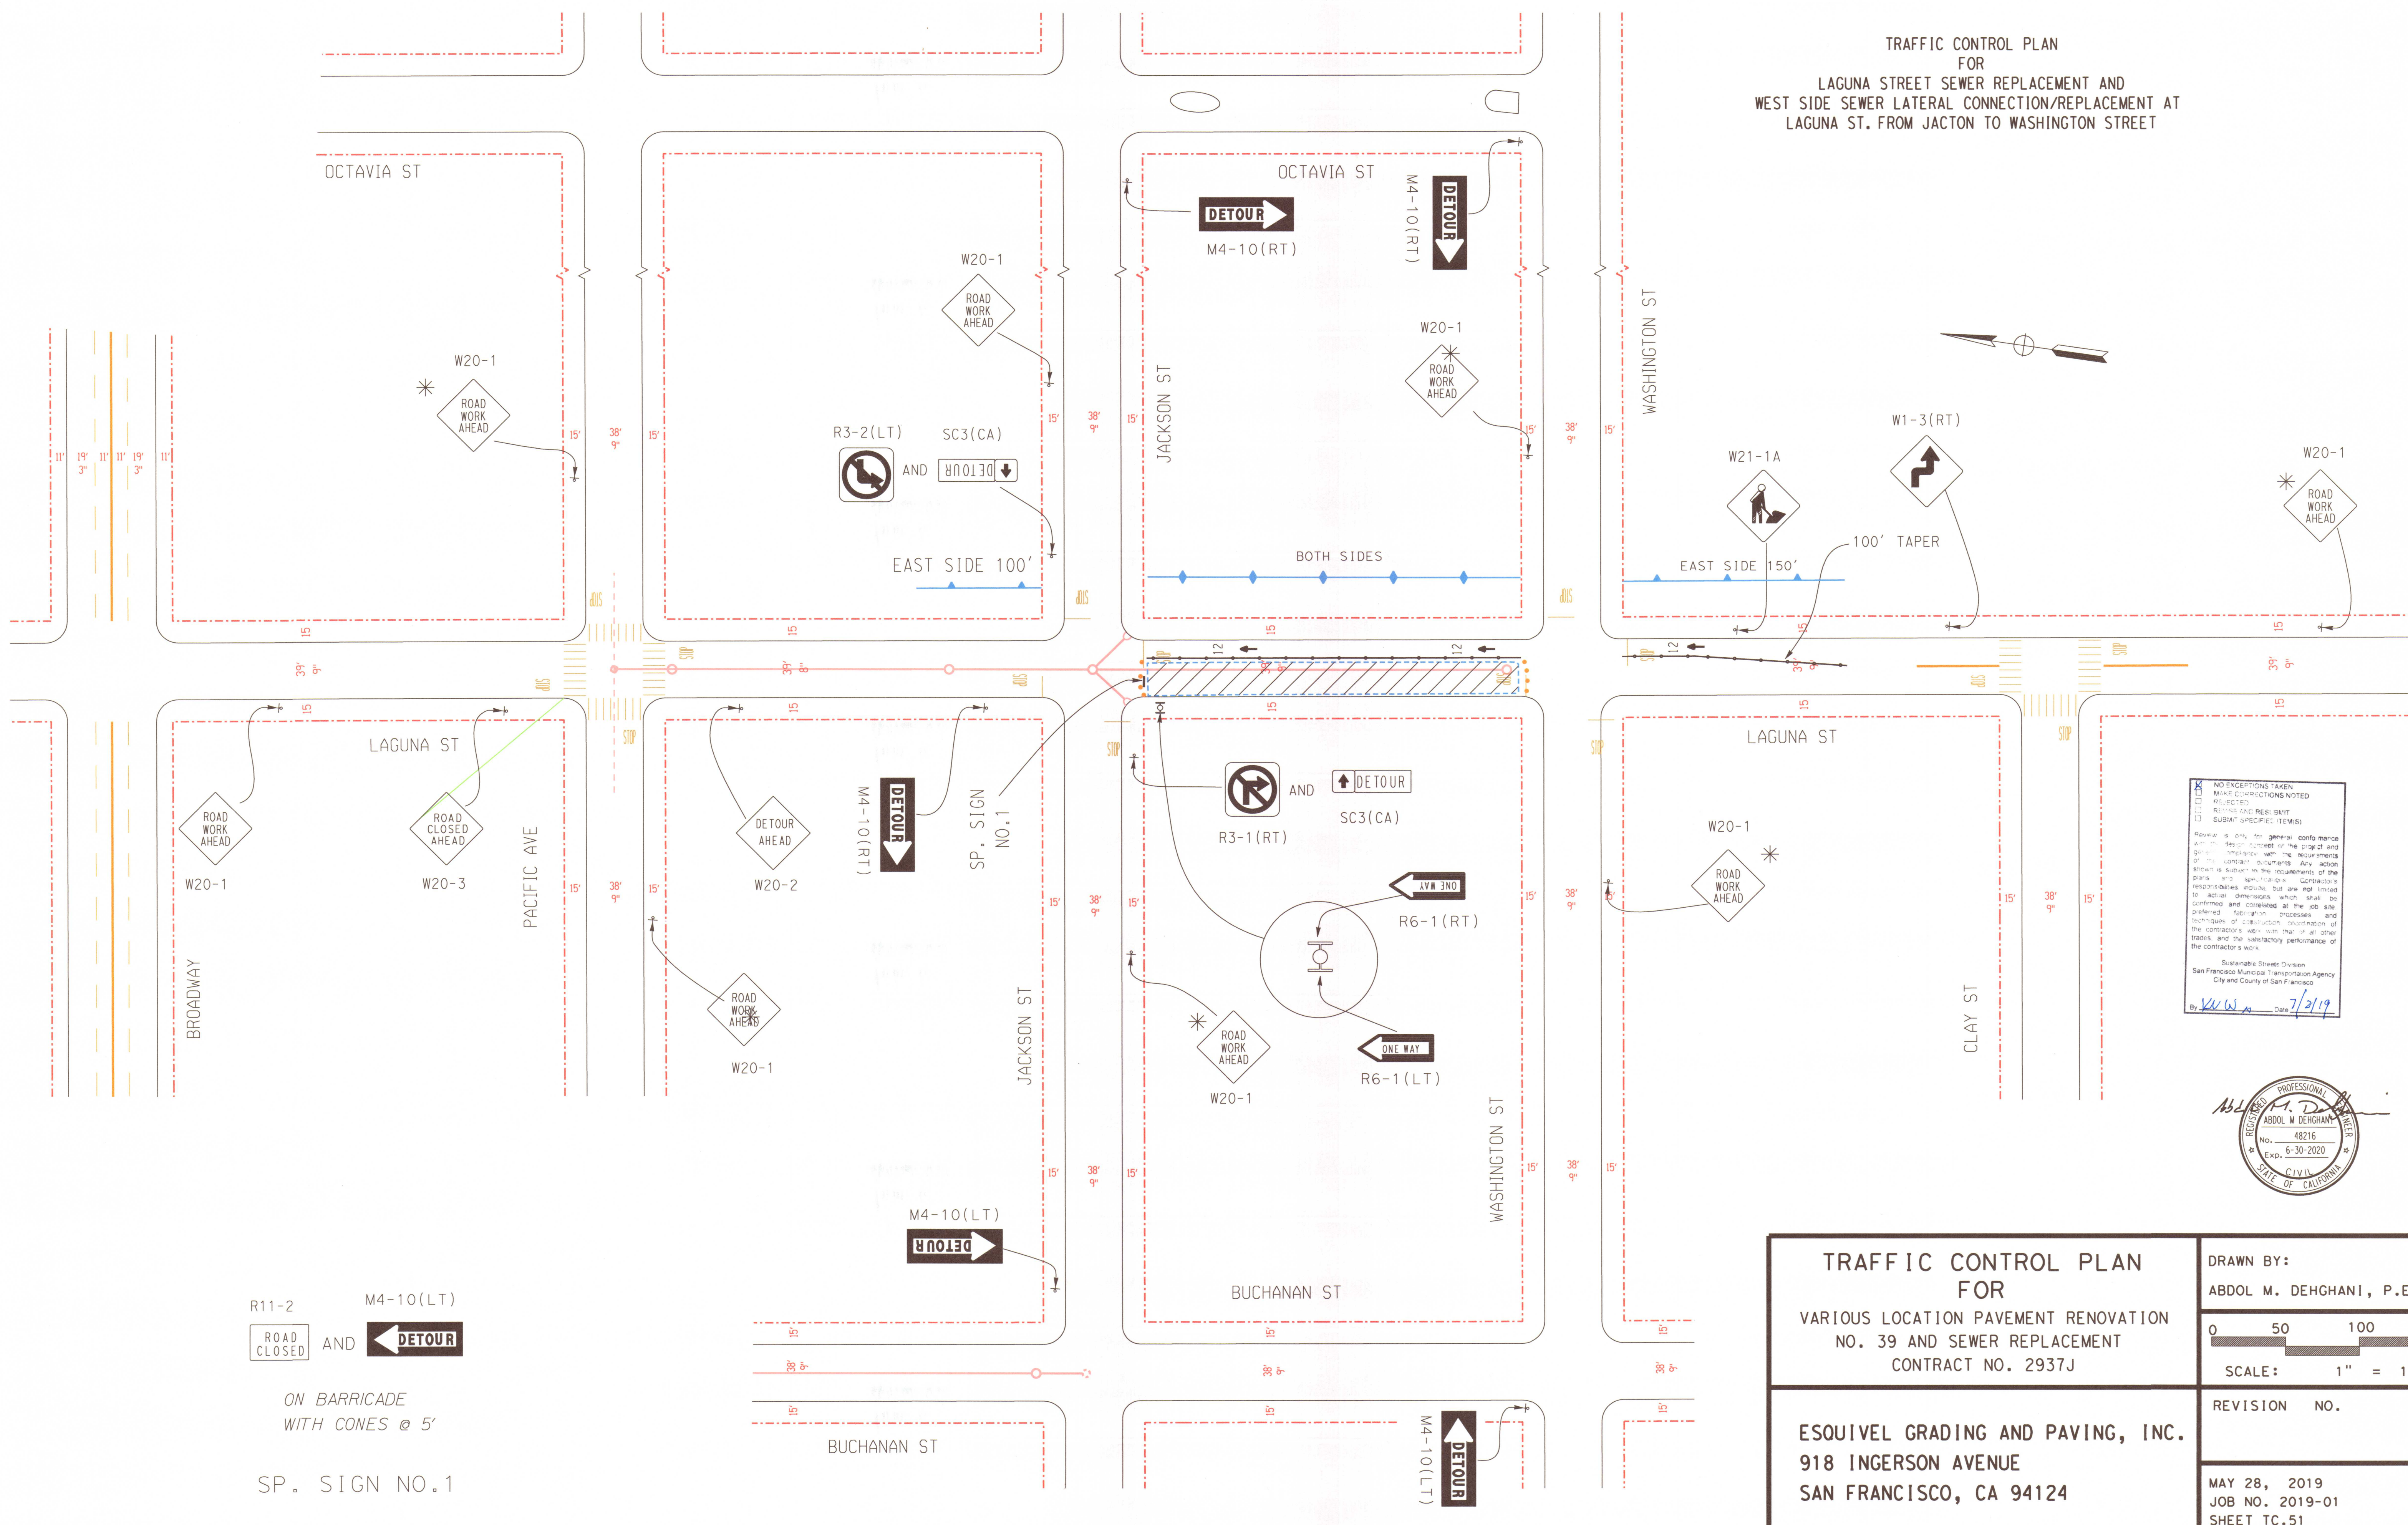


NO EXCEPTIONS TAKEN
MAKE CORRECTIONS NOTED
REJECTED
REVISED AND RESUBMIT
SUBMIT SPECIFIC ITEMS

Review is only for general conformance with the design of the project and general compliance with the requirements of the contract documents. Any action taken by the contractor shall be the responsibility of the contractor. The contractor shall be responsible for the design, construction, and maintenance of the project. The contractor shall be responsible for the design, construction, and maintenance of the project. The contractor shall be responsible for the design, construction, and maintenance of the project.

Sustainable Streets Division
San Francisco Municipal Transportation Agency
City and County of San Francisco

By *W.W.A.* Date *7/2/19*

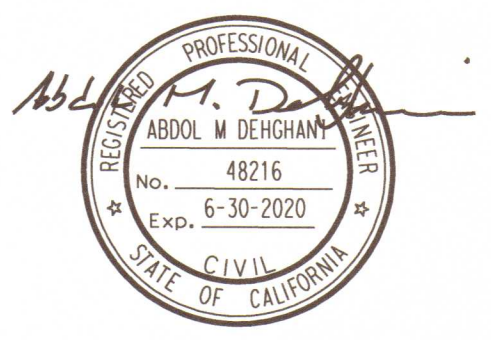

R11-2 M4-10(LT)
ROAD CLOSED AND DETOUR
ON BARRICADE
WITH CONES @ 5'
SP. SIGN NO.1

TRAFFIC CONTROL PLAN FOR VARIOUS LOCATION PAVEMENT RENOVATION NO. 39 AND SEWER REPLACEMENT CONTRACT NO. 2937J		DRAWN BY: ABDOL M. DEGHANI, P.E.
ESQUIVEL GRADING AND PAVING, INC. 918 INGERSON AVENUE SAN FRANCISCO, CA 94124		0 50 100 150 SCALE: 1" = 100
		REVISION NO.
		MAY 28, 2019 JOB NO. 2019-01 SHEET TC.51