


TRAFFIC CONTROL PLAN
FOR
LAGUNA ST. CURB RAMP RECONSTRUCTION
AT MAGNOLIA, GREENWICH, AND FILBERT STREETS INTERSECTIONS
PHASE "C"
DURING WORKING HOURS

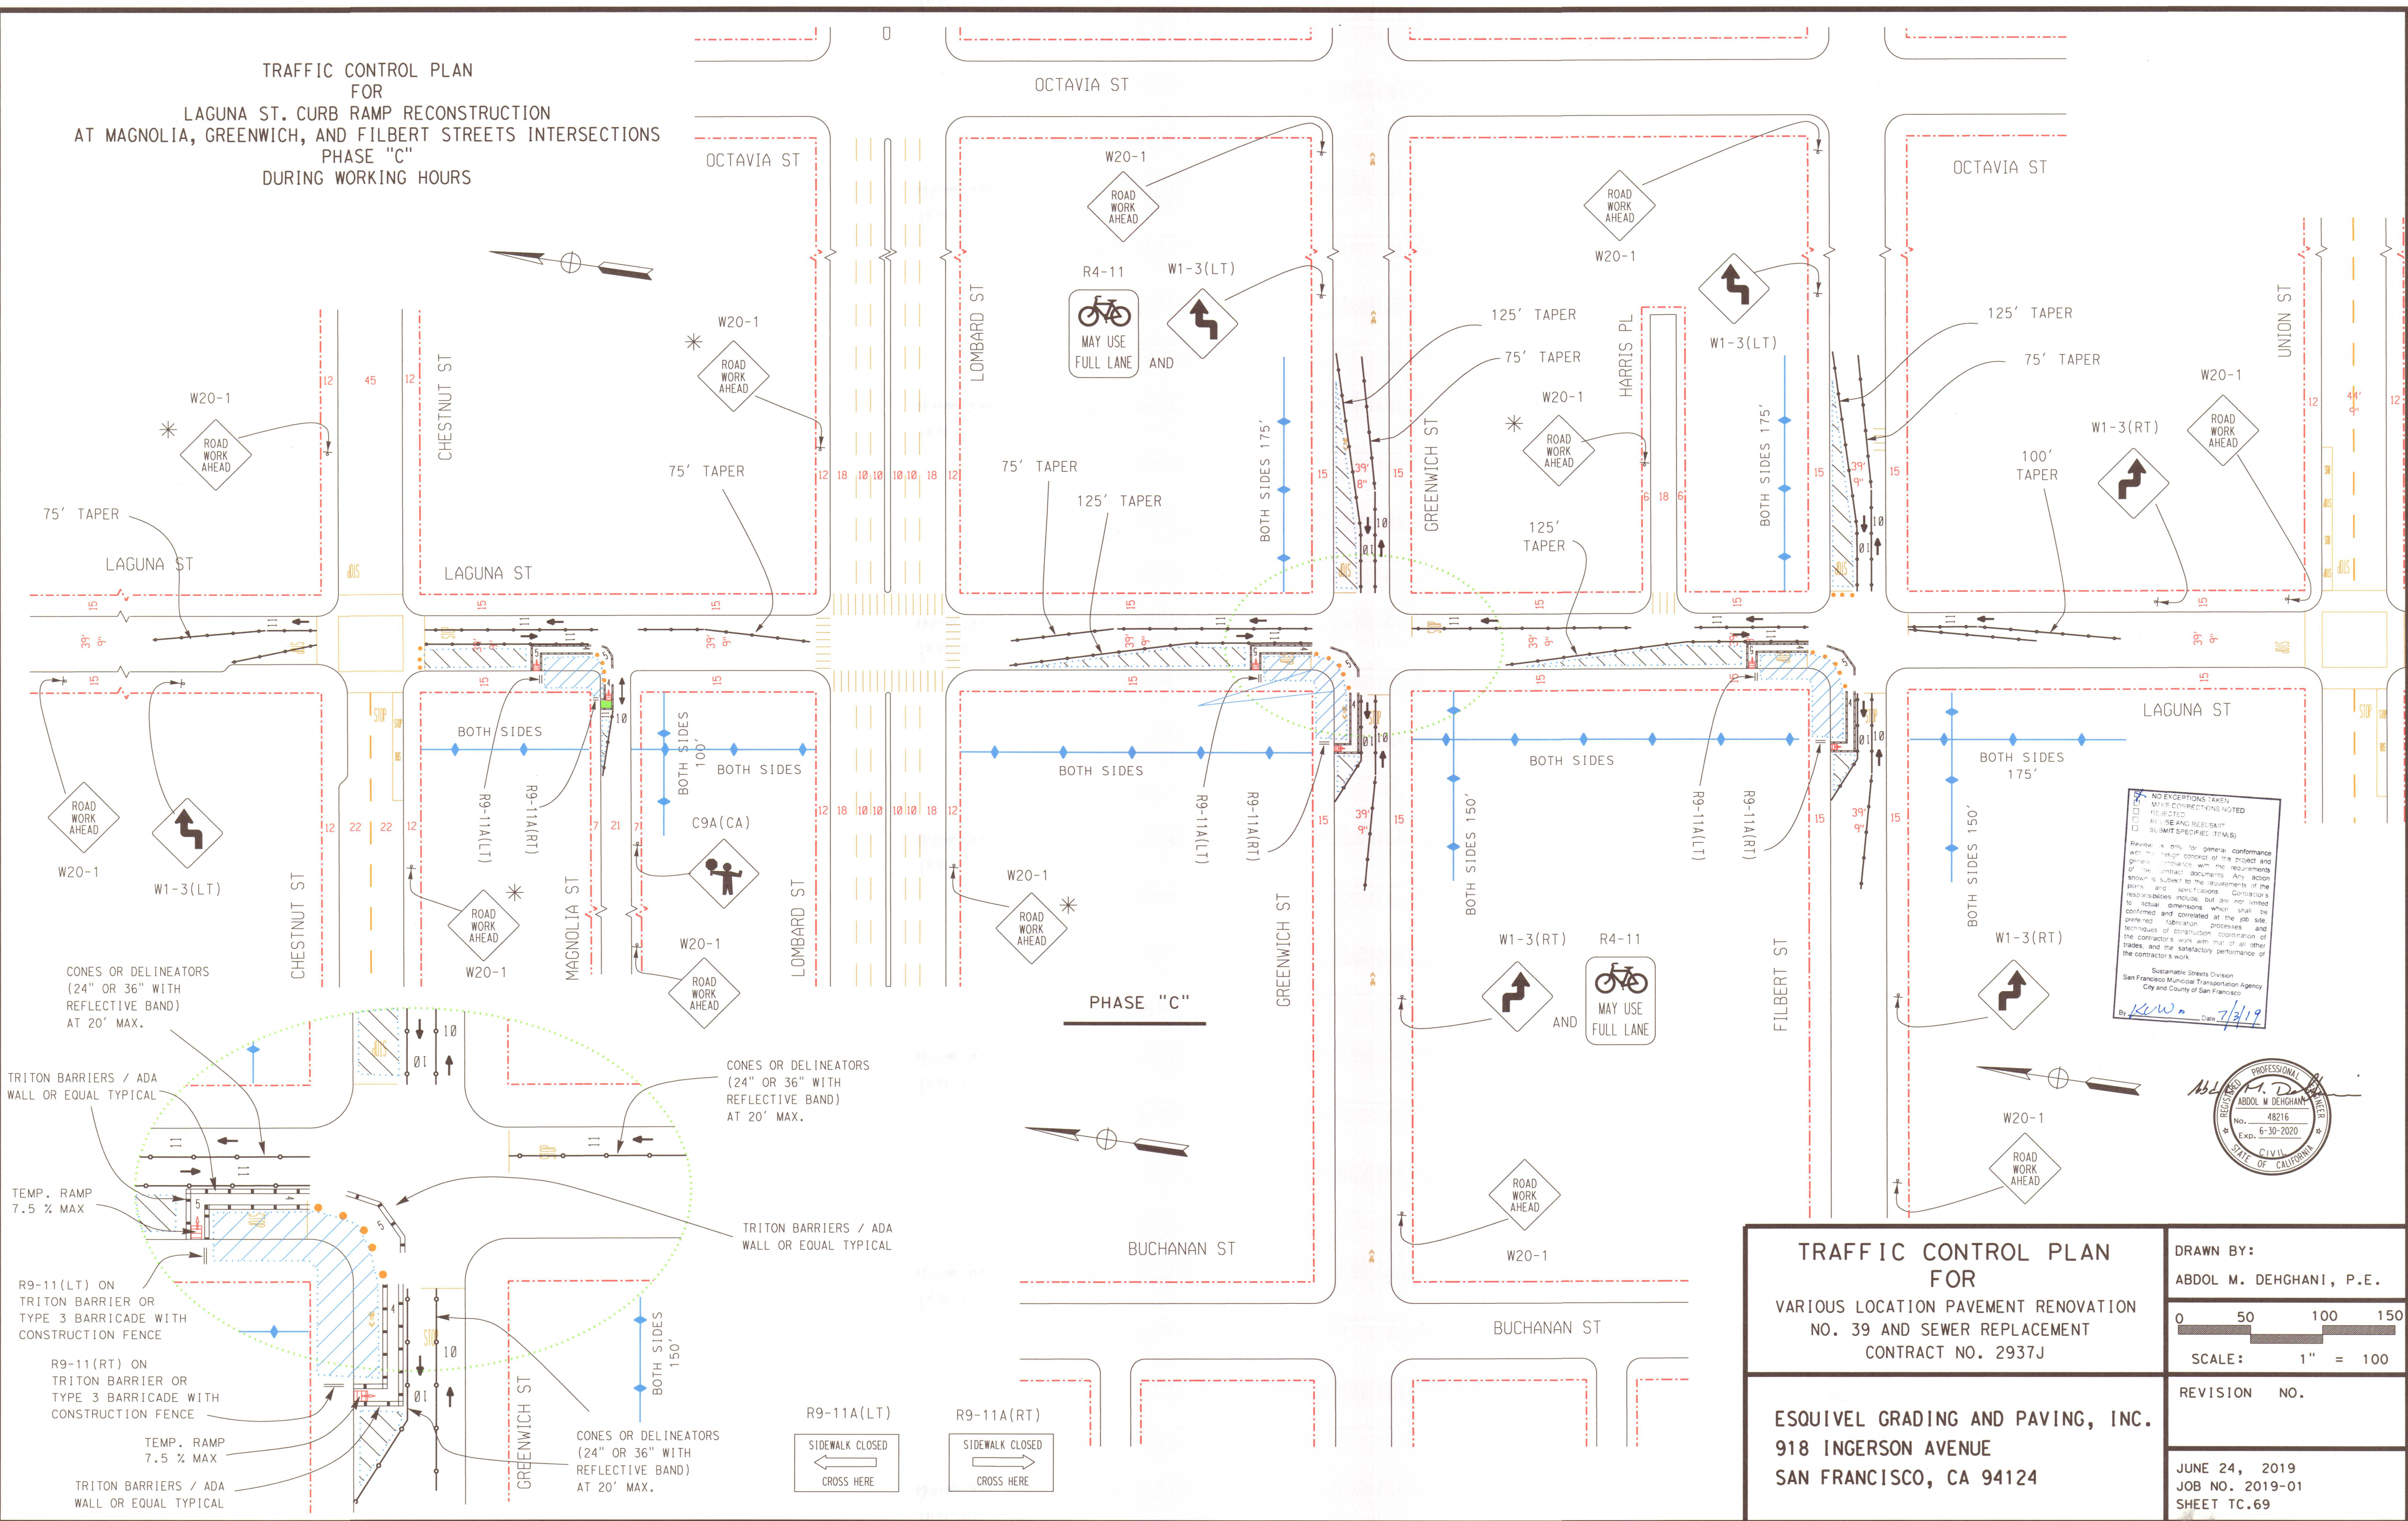


NO EXCEPTIONS TAKEN
MAKE CORRECTIONS NOTED
REJECTED
REVISE AND RESUBMIT
SUBMIT SPECIFIC ITEMS

Review is only for general conformance with the design concept of the project and general compliance with the requirements of the contract documents. Any action plans and specifications of the responsibilities include, but are not limited to, confirmed and corrected at the job site, techniques of construction, coordination of trades, and the satisfactory performance of the contractor's work.

Sustainable Streets Division
San Francisco Municipal Transportation Agency
City and County of San Francisco

By *KW* Date *7/3/19*

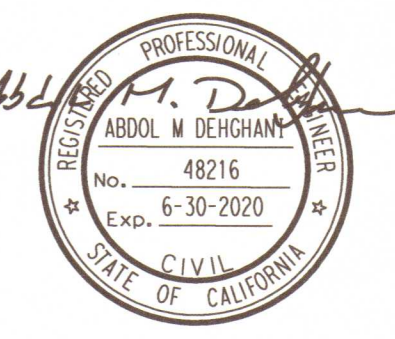

TRAFFIC CONTROL PLAN FOR VARIOUS LOCATION PAVEMENT RENOVATION NO. 39 AND SEWER REPLACEMENT CONTRACT NO. 2937J		DRAWN BY: ABDOL M. DEHGHANI, P.E.
ESQUIVEL GRADING AND PAVING, INC. 918 INGERSON AVENUE SAN FRANCISCO, CA 94124		SCALE: 1" = 100' REVISION NO. JUNE 24, 2019 JOB NO. 2019-01 SHEET TC.69