
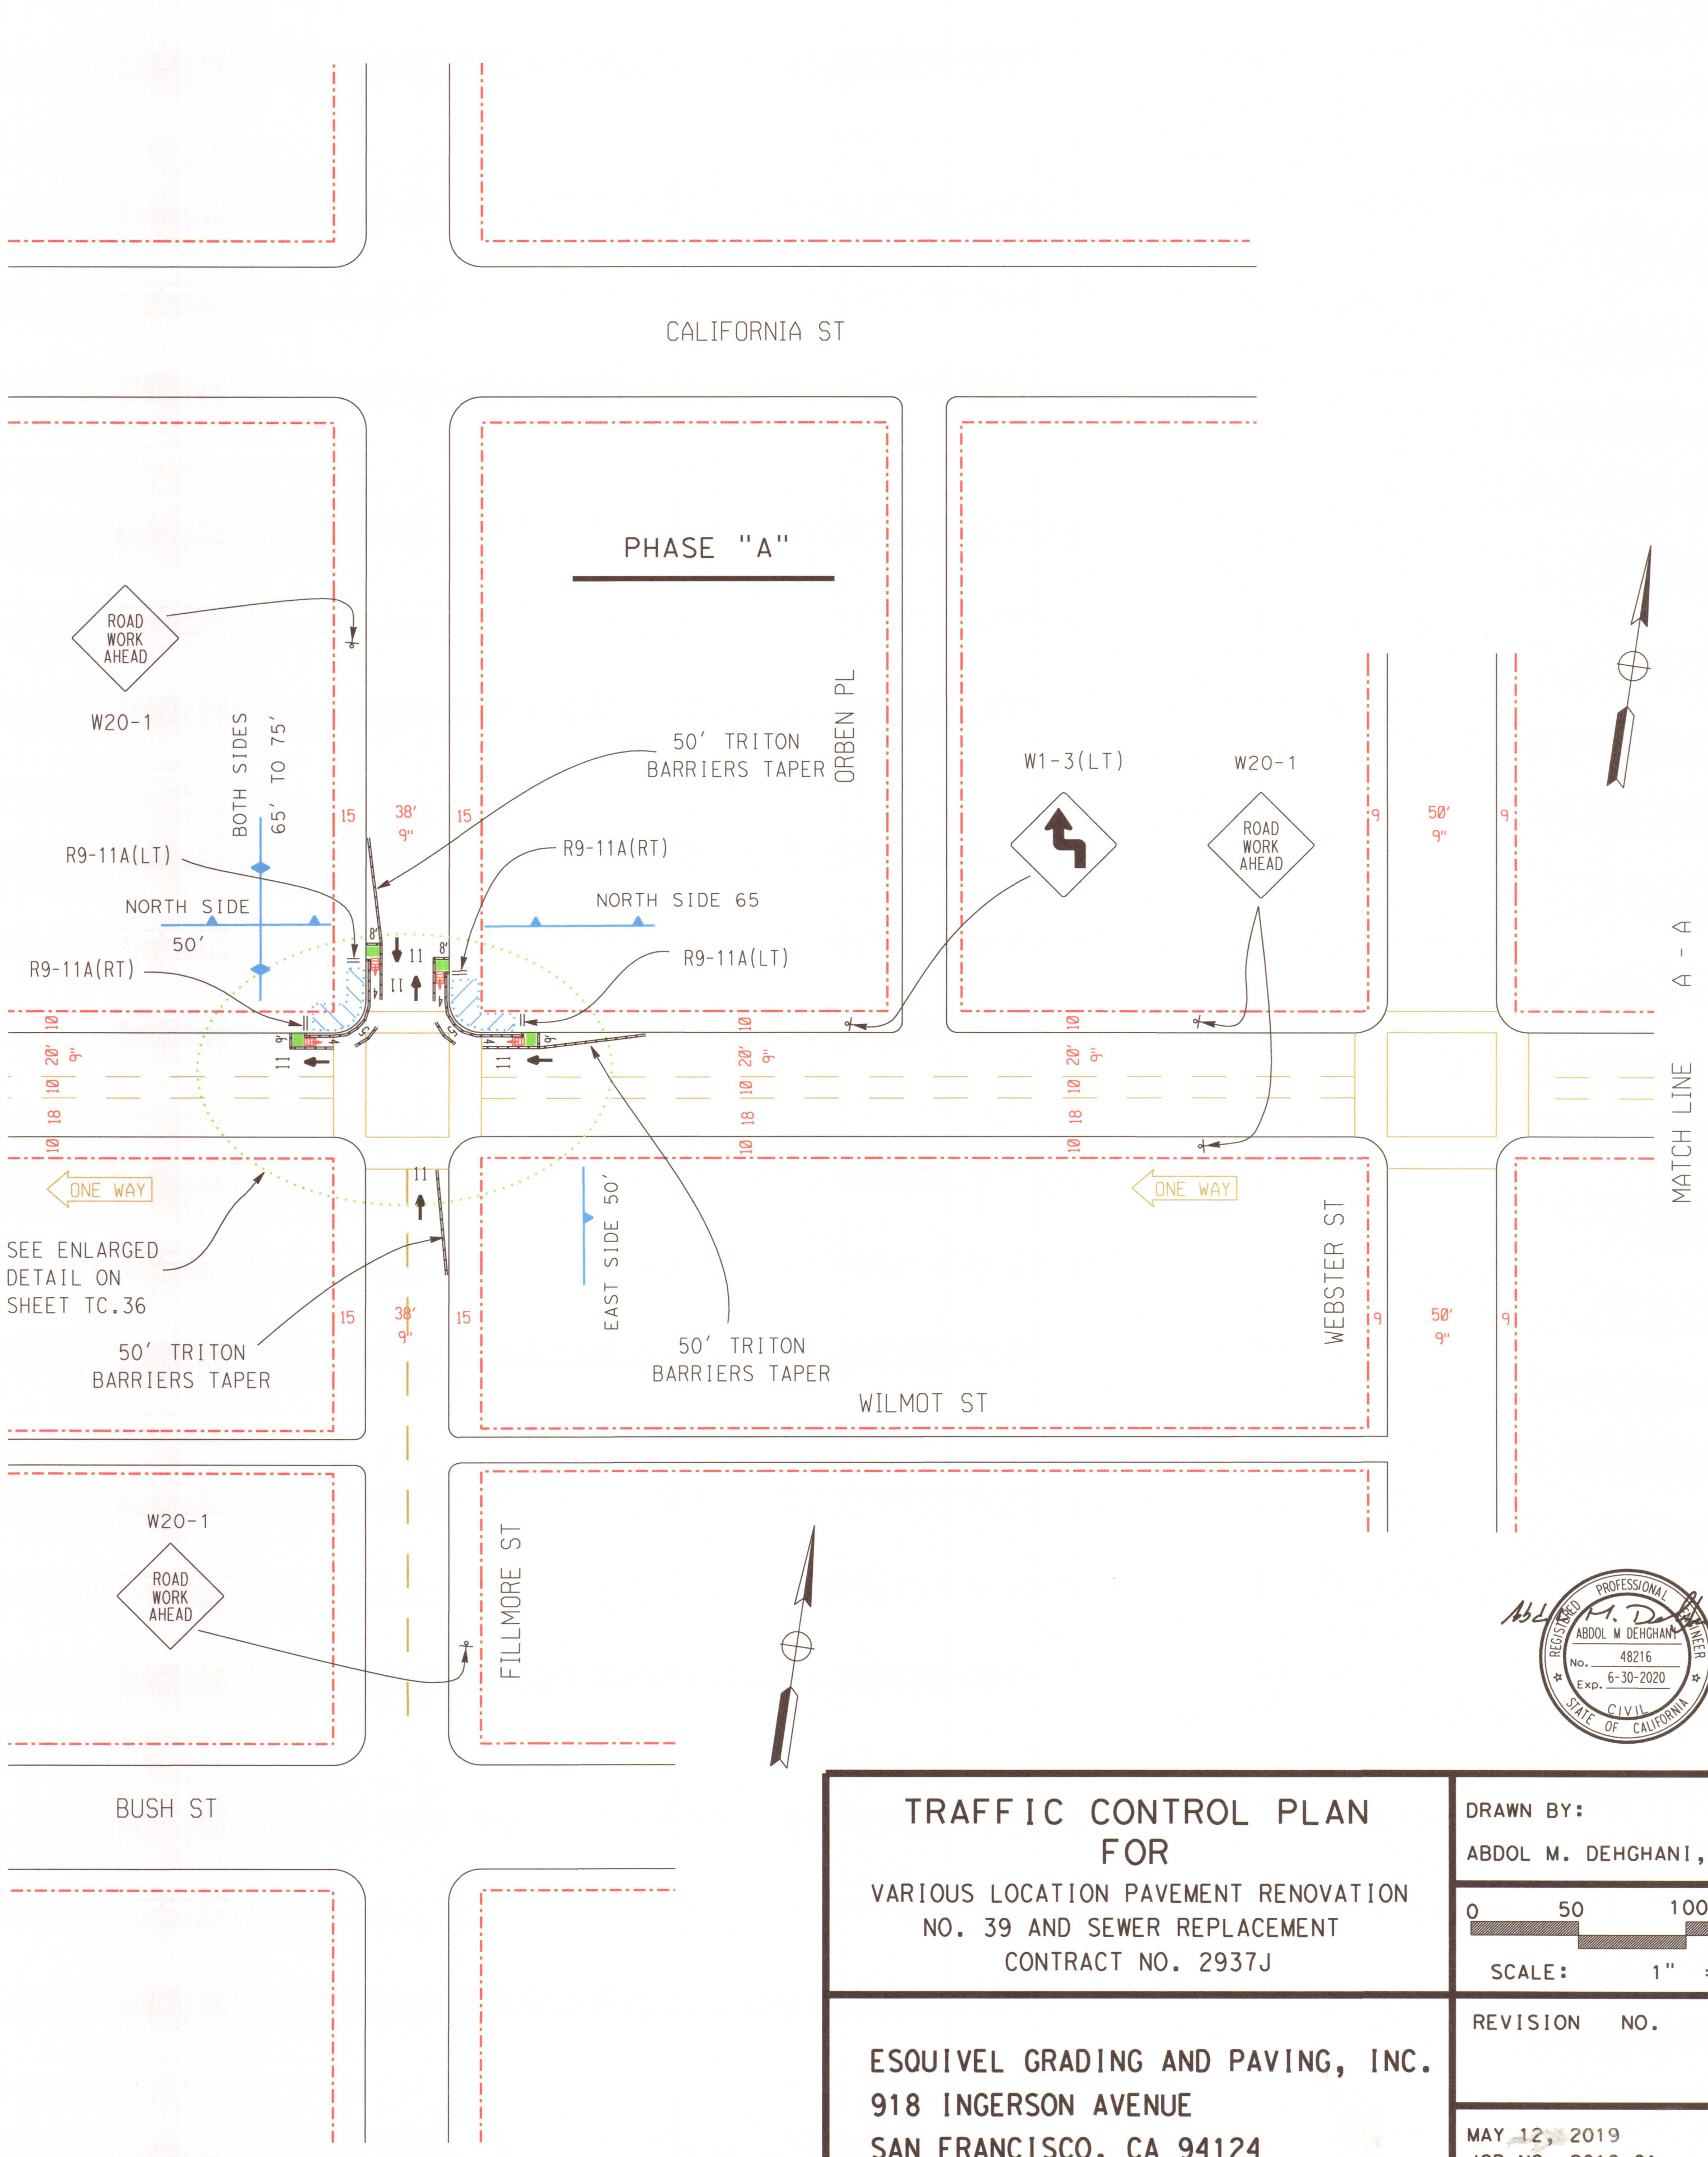


ALTERNATIVE TRAFFIC CONTROL PLAN
FOR
PINE STREET CURB RAMP RECONSTRUCTION AT
FILLMORE AND PINE STREET INTERSECTION
PHASE "A" AND "B"
DURING NON-WORKING HOURS

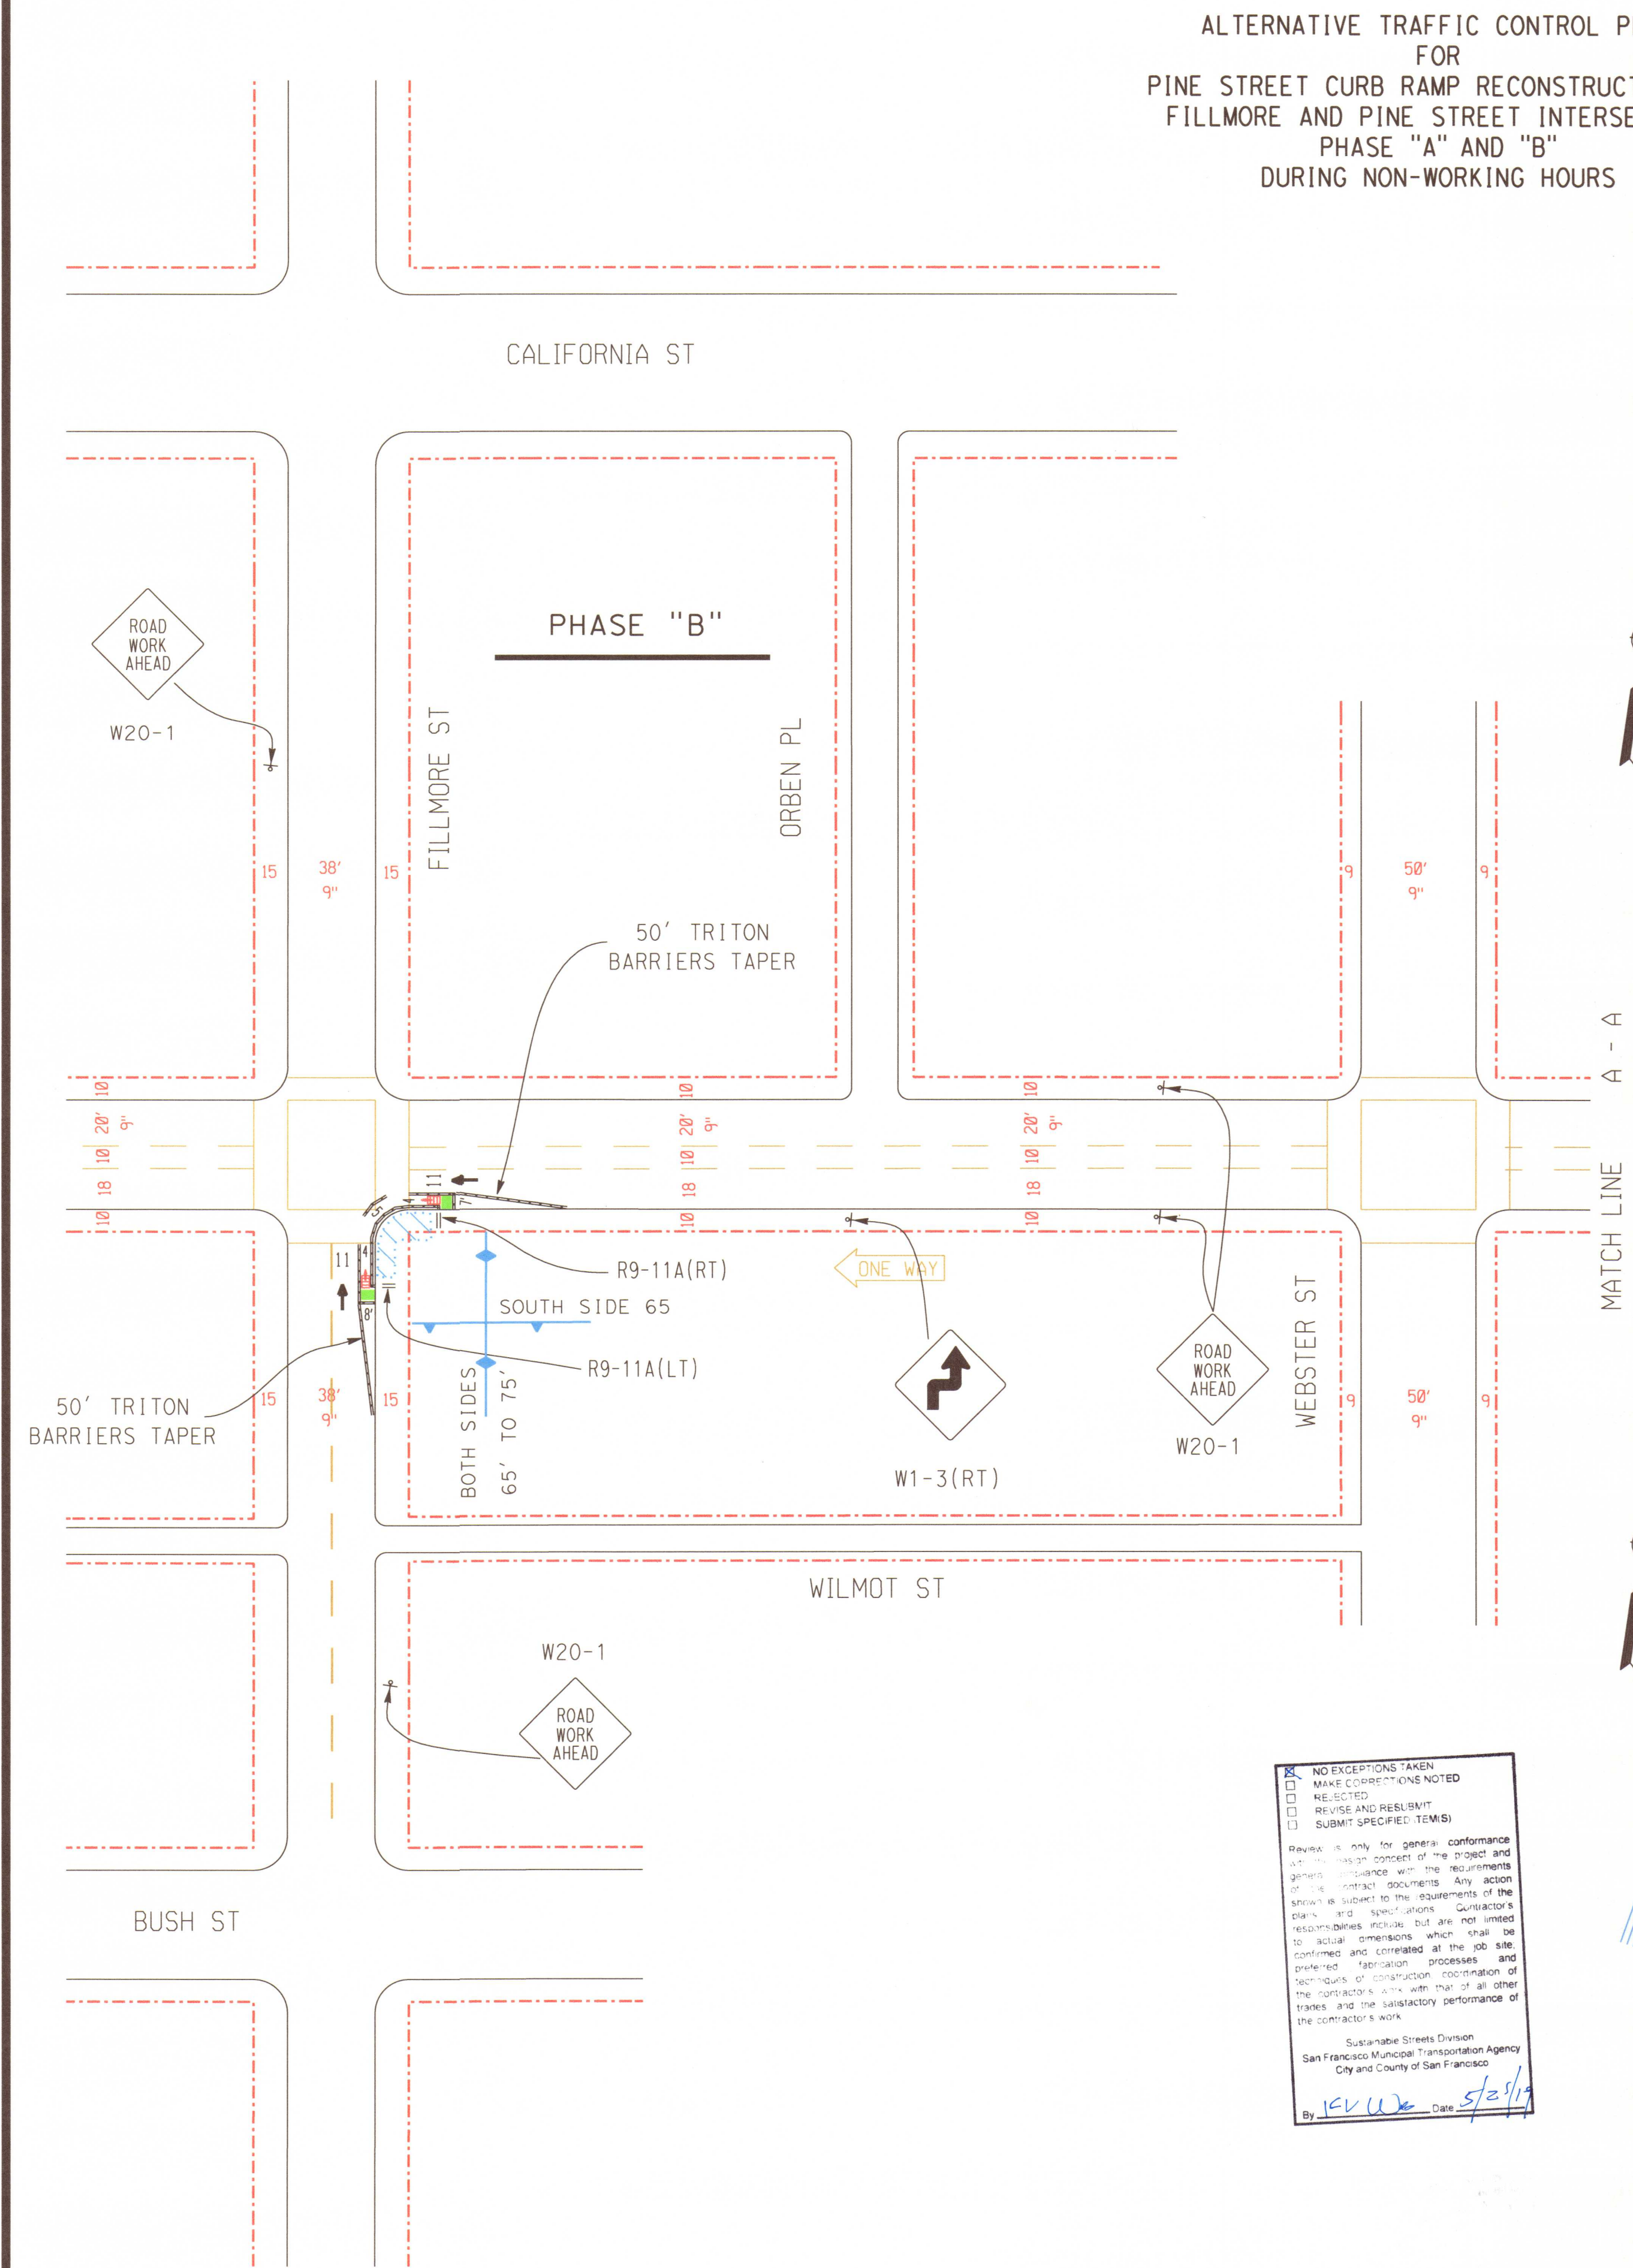

NO EXCEPTIONS TAKEN
MAKE CORRECTIONS NOTED
REJECTED
REVISE AND RESUBMIT
SUBMIT SPECIFIED ITEMS

Revised only for general conformance
with the project and the requirements
of the contract documents. Any action
taken is subject to the requirements of the
contract documents. Contractor's
responsibilities include, but are not limited
to, actual construction, coordination of
the contractor's work with that of all other
trades and the satisfactory performance of
the contractor's work.

Sustainable Streets Division
San Francisco Municipal Transportation Agency
City and County of San Francisco

By: *KEV W* Date: *5/25/19*

PROFESSIONAL
ABDOL M. DEGHANI
No. 48216
Exp. 6-30-2020
CIVIL
STATE OF CALIFORNIA

TRAFFIC CONTROL PLAN
FOR
VARIOUS LOCATION PAVEMENT RENOVATION
NO. 39 AND SEWER REPLACEMENT
CONTRACT NO. 2937J

ESQUIVEL GRADING AND PAVING, INC.
918 INGERSON AVENUE
SAN FRANCISCO, CA 94124

DRAWN BY:
ABDOL M. DEGHANI, P.E.

0 50 100 150
SCALE: 1" = 100

REVISION NO.

MAY 12, 2019
JOB NO. 2019-01
SHEET TC.43