


TRAFFIC CONTROL PLAN
FOR
EAST SIDE SEWER LATERAL REPLACEMENT AT
LAGUNA ST. (EAST SIDE) FROM JACKSON TO WASHINGTON STREETS

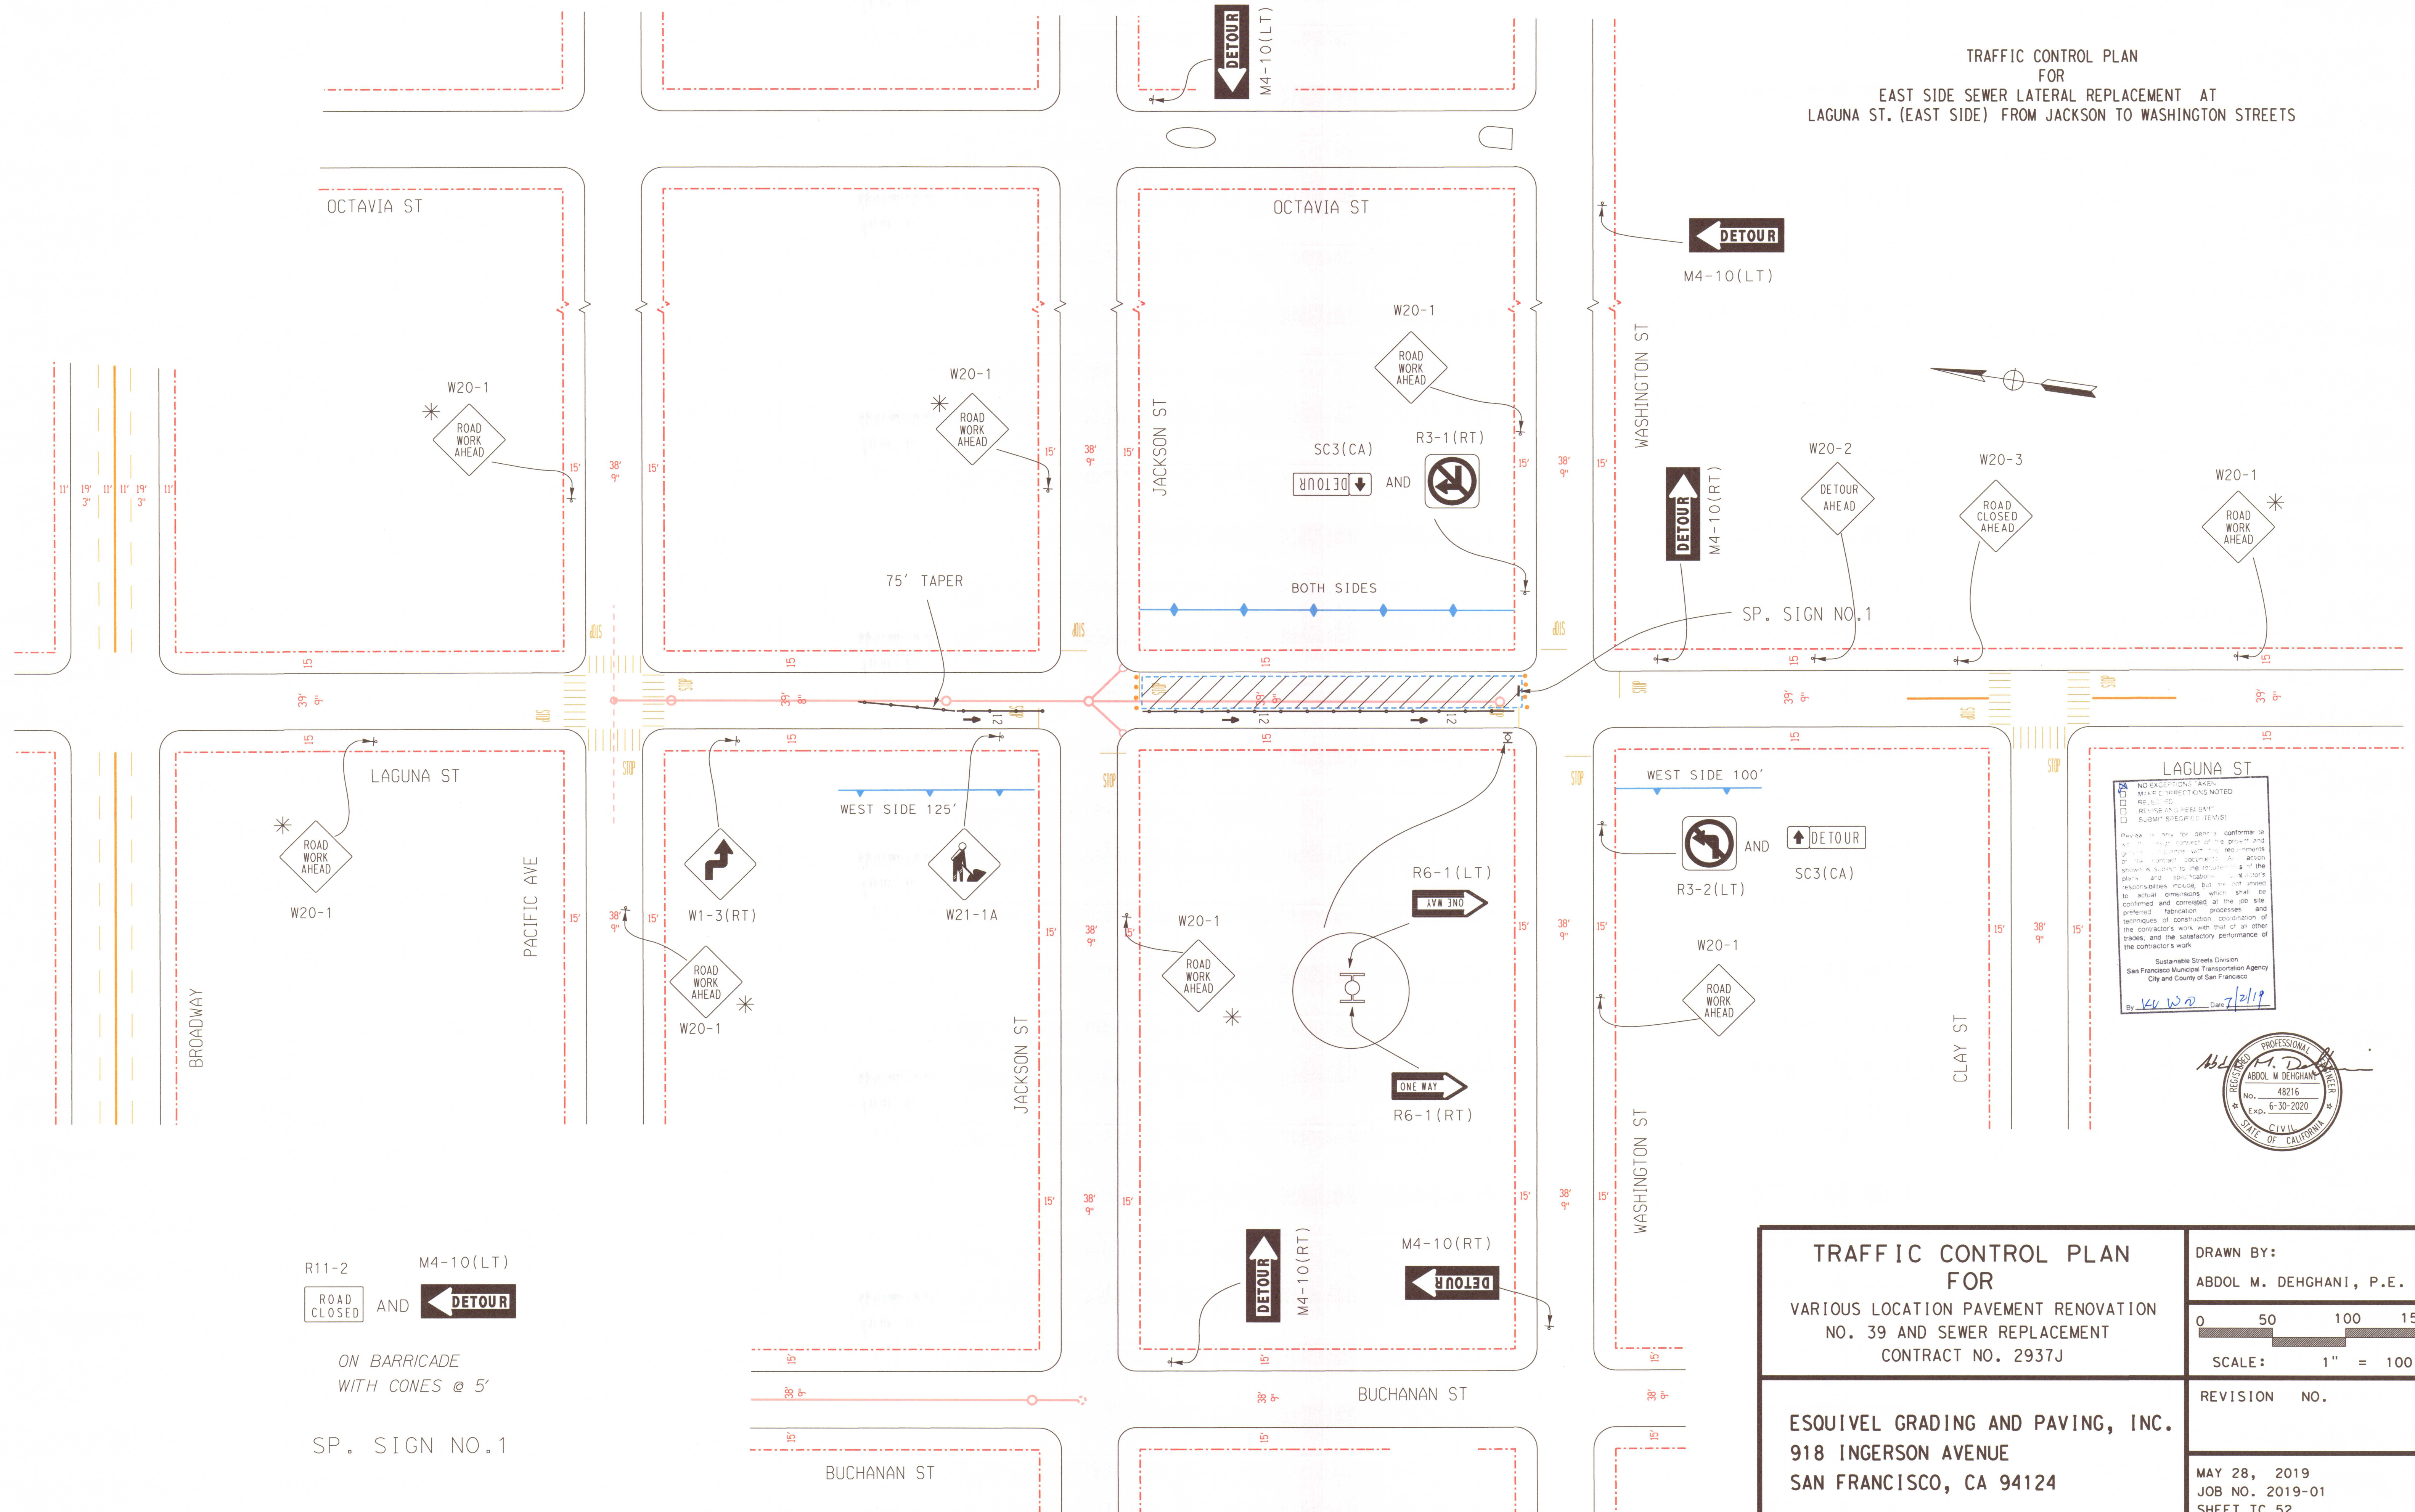

TRAFFIC CONTROL PLAN
FOR
VARIOUS LOCATION PAVEMENT RENOVATION
NO. 39 AND SEWER REPLACEMENT
CONTRACT NO. 2937J

DRAWN BY:
ABDOL M. DEGHANI, P.E.

0 50 100 150

SCALE: 1" = 100'

ESQUIVEL GRADING AND PAVING, INC.
918 INGERSON AVENUE
SAN FRANCISCO, CA 94124

REVISION	NO.
MAY 28, 2019	
JOB NO. 2019-01	
SHEET TC.52	