


TRAFFIC CONTROL PLAN  
FOR  
LAGUNA STREET SEWER REPLACEMENT AND  
WEST SIDE SEWER LATERAL CONNECTION/REPLACEMENT AT  
LAGUNA ST. FROM GREENWICH TO FILBERT STREETS

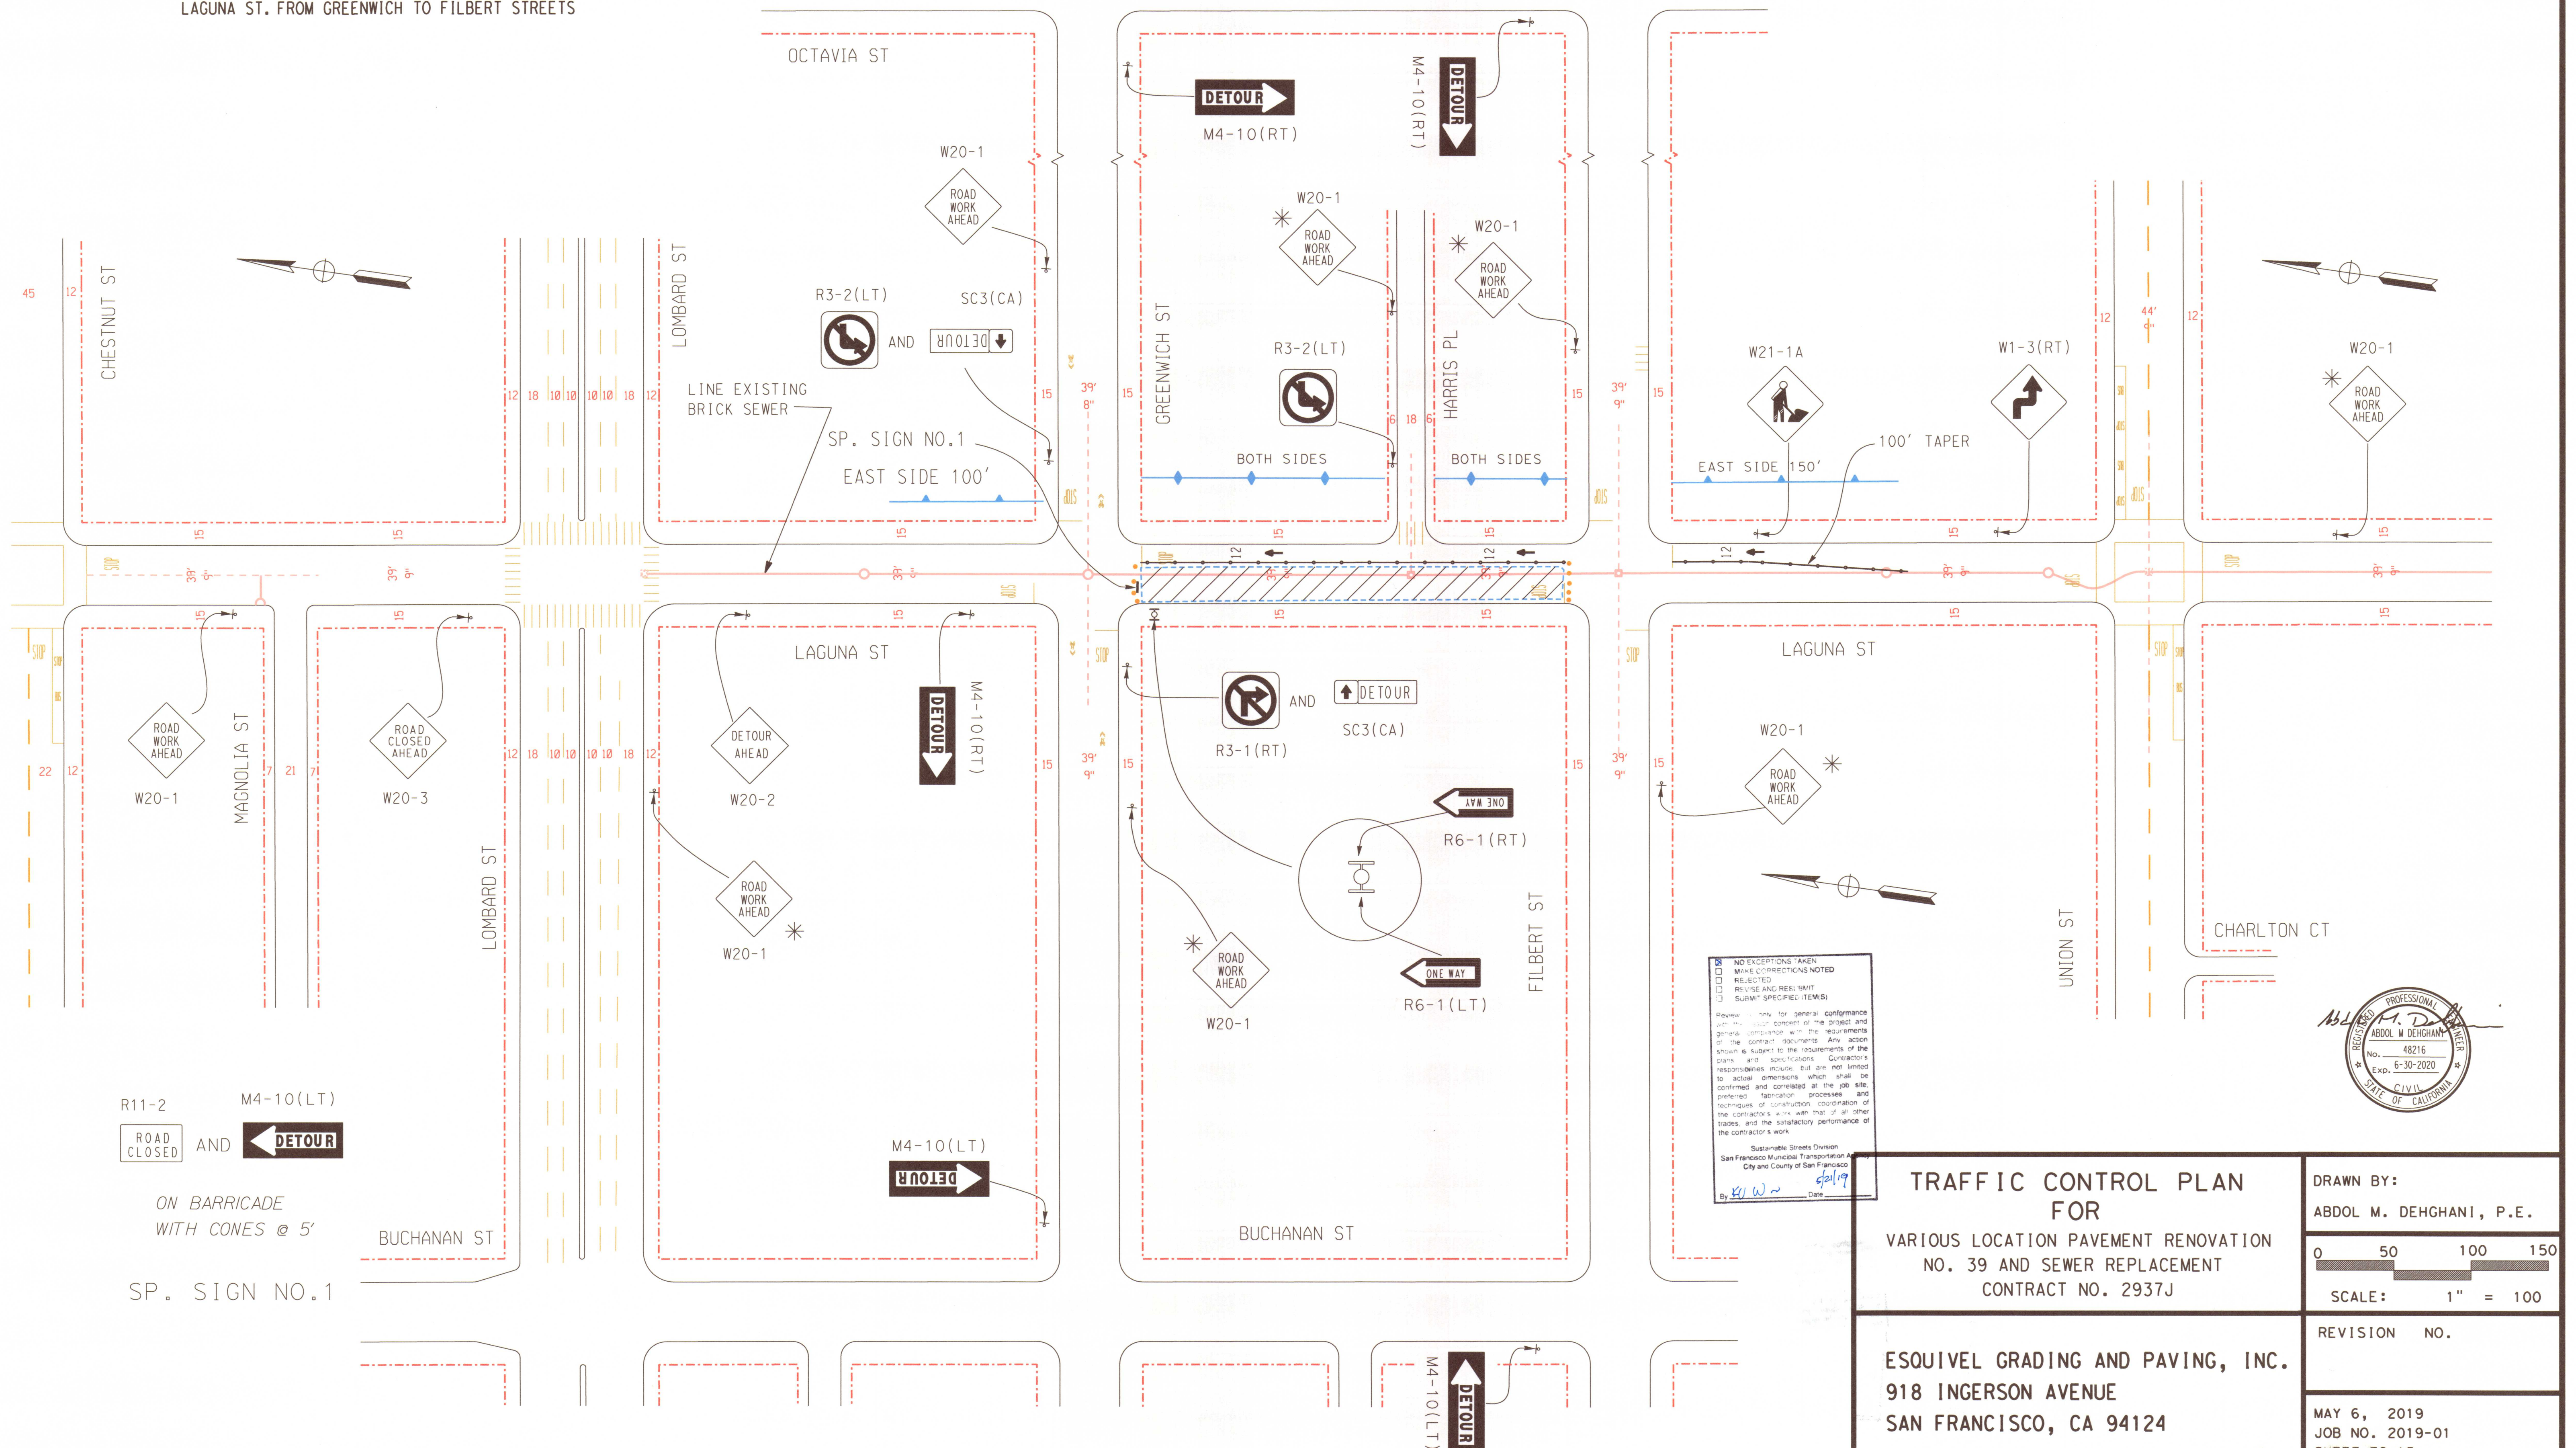

TRAFFIC CONTROL PLAN  
FOR  
VARIOUS LOCATION PAVEMENT RENOVATION  
NO. 39 AND SEWER REPLACEMENT  
CONTRACT NO. 2937J

ESQUIVEL GRADING AND PAVING, INC.  
918 INGERSON AVENUE  
SAN FRANCISCO, CA 94124

DRAWN BY:  
ABDOL M. DEGHANI, P.E.

0 50 100 150  
SCALE: 1" = 100

REVISION NO.

MAY 6, 2019  
JOB NO. 2019-01  
SHEET TC.15