
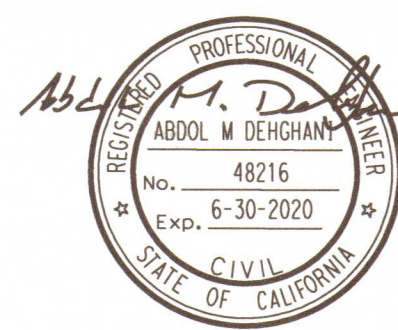


TRAFFIC CONTROL PLAN
FOR
LAGUNA STREET SEWER REPLACEMENT AND
WEST SIDE SEWER LATERAL CONNECTION/REPLACEMENT AT
LAGUNA ST. FROM GREEN TO VALLEJO STREETS

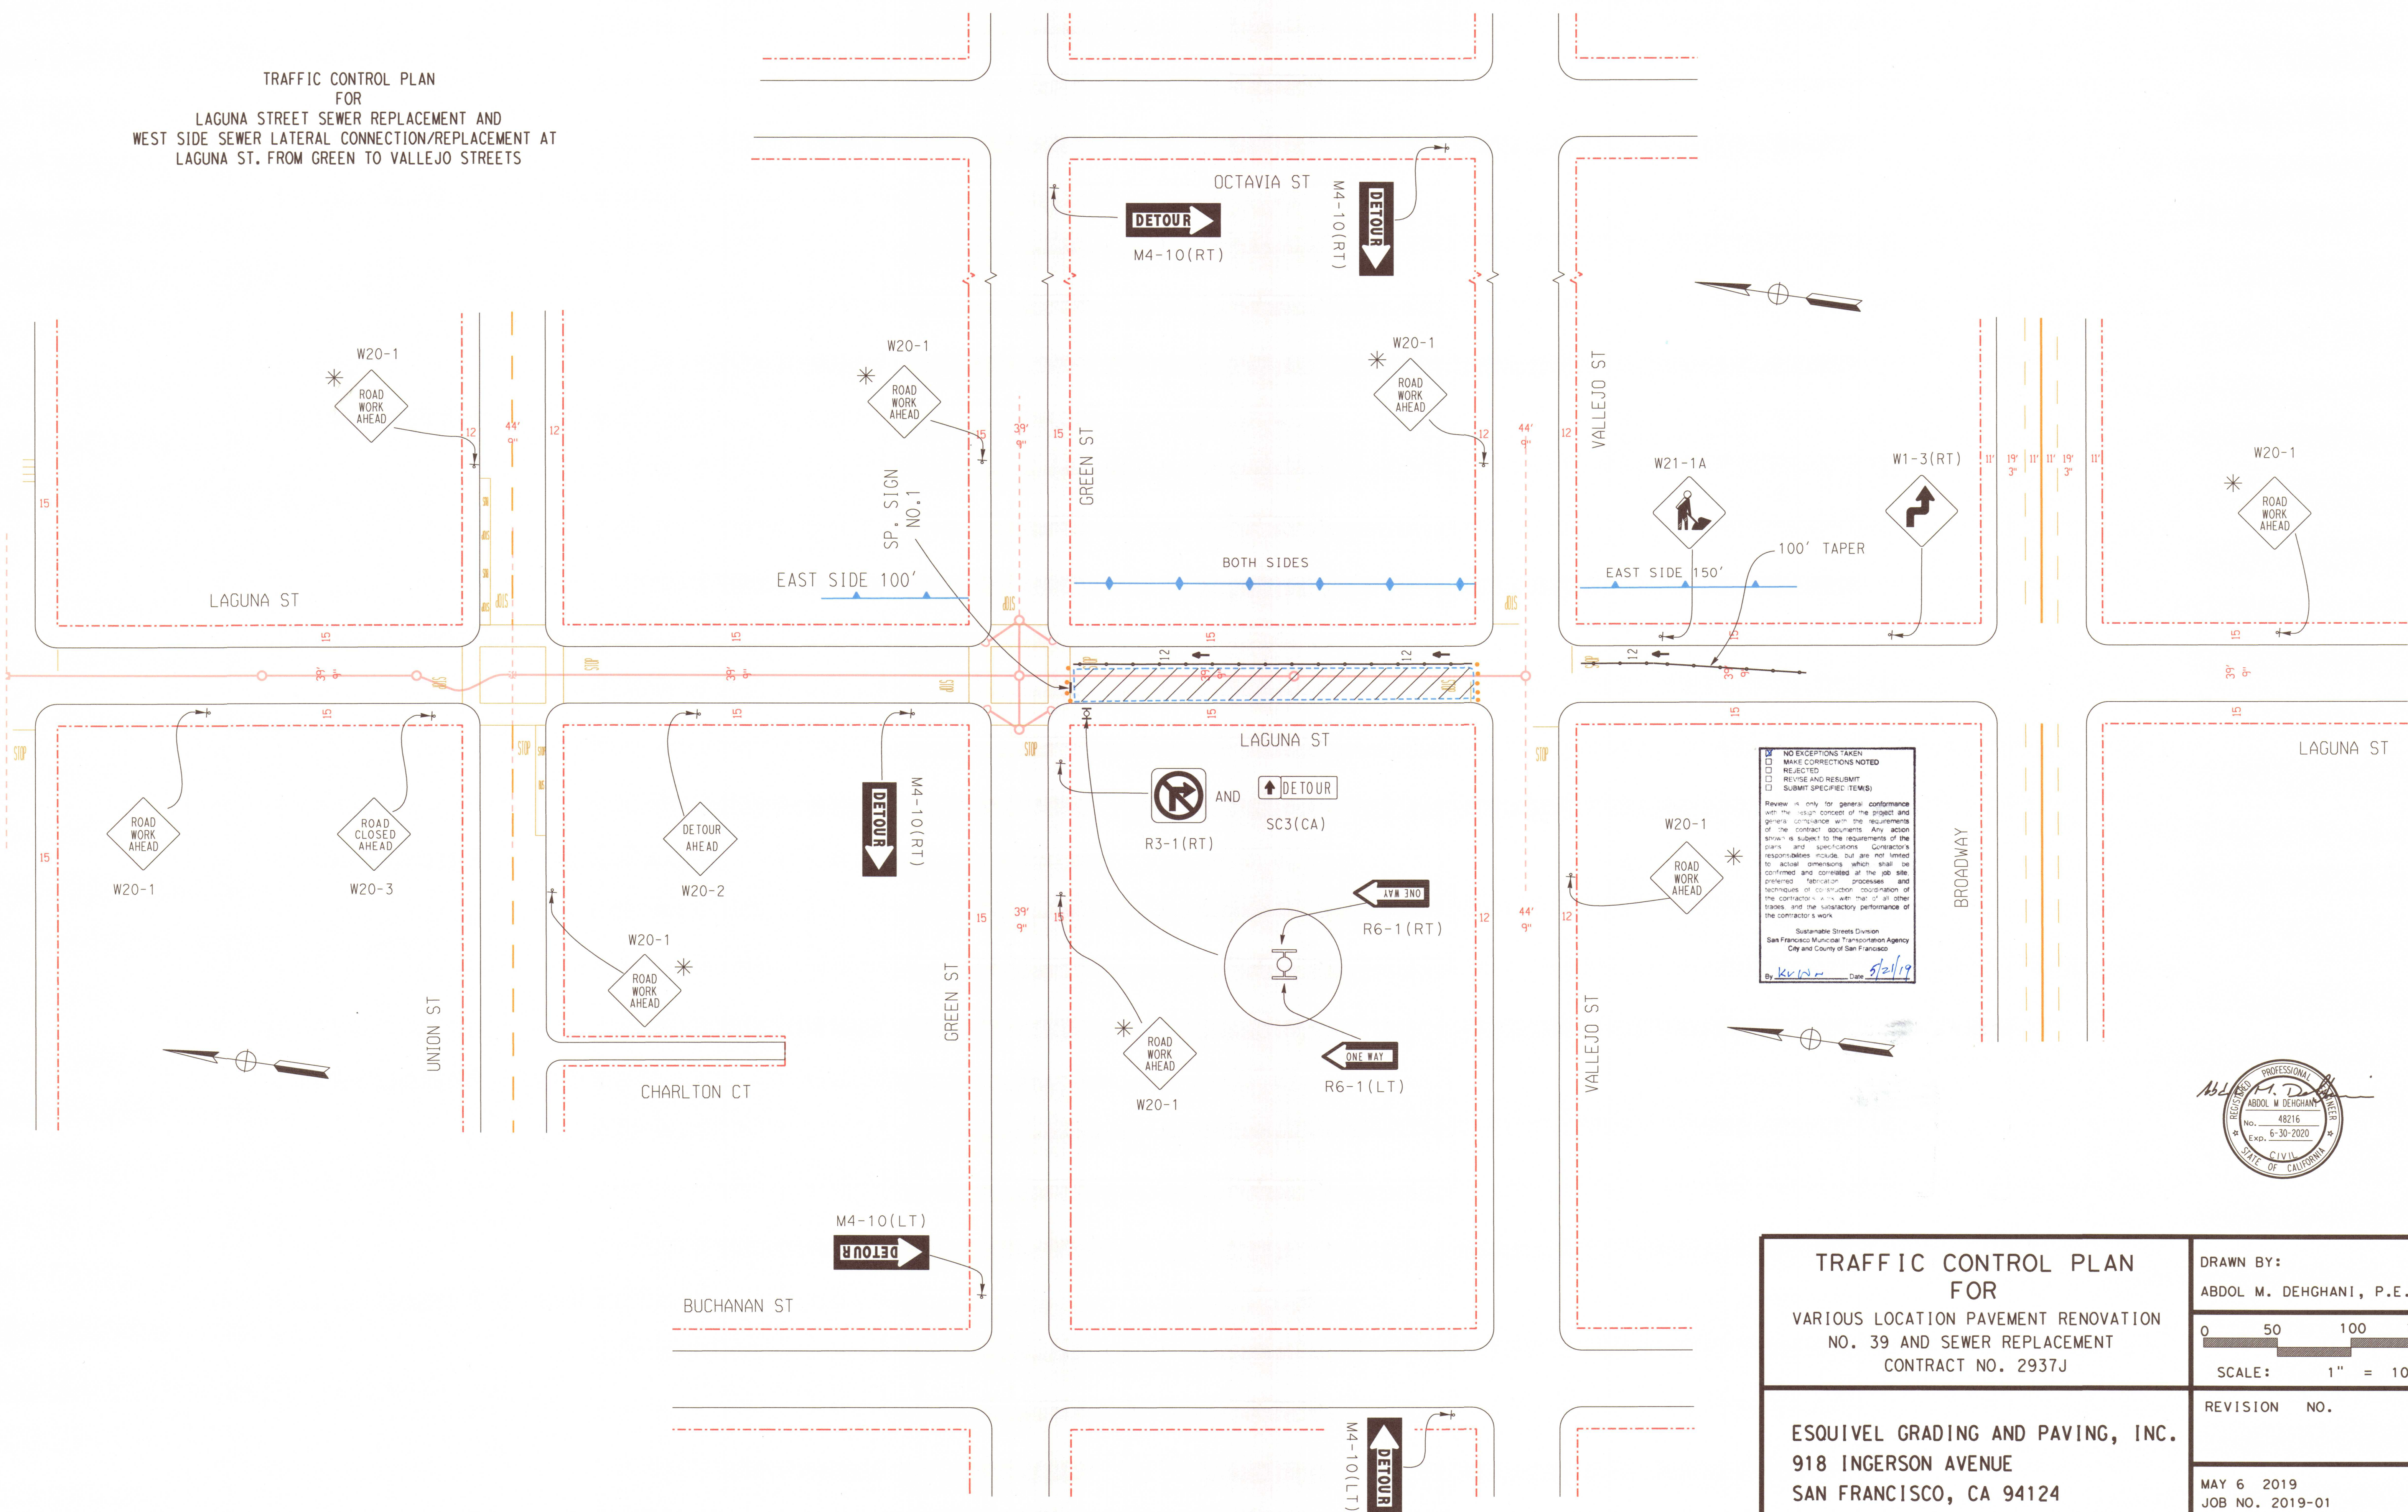

TRAFFIC CONTROL PLAN FOR VARIOUS LOCATION PAVEMENT RENOVATION NO. 39 AND SEWER REPLACEMENT CONTRACT NO. 2937J	DRAWN BY: ABDOL M. DEHGHANI, P.E.
	0 50 100 150 SCALE: 1" = 100'
ESQUIVEL GRADING AND PAVING, INC. 918 INGERSON AVENUE SAN FRANCISCO, CA 94124	REVISION NO.
	MAY 6 2019 JOB NO. 2019-01 SHEET TC.21