


NO EXCEPTIONS TAKEN
MAKE CORRECTIONS NOTED
NO. 68762
4/1/19 6/18/19
SUBMIT SPECIFIED ITEMS

Review is only for general performance and does not constitute a warranty of the project and is not a substitute for the requirements of the contract documents. Any action taken by the contractor shall be the responsibility of the contractor. The contractor's responsibilities include, but are not limited to, installation, dimensions, which shall be confirmed and controlled at the job site, preferred fabrication processes and techniques of construction, coordination of the contractor's work with that of all other trades, and the satisfactory performance of the contractor's work.

Sustainable Streets Division
San Francisco Municipal Transportation Agency
City and County of San Francisco

By: *[Signature]* Date: 6/18/19

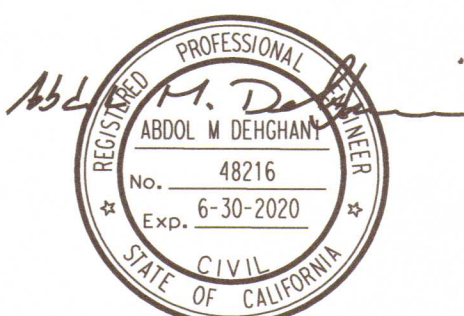

TRAFFIC CONTROL PLAN FOR VARIOUS LOCATION PAVEMENT RENOVATION NO. 39 AND SEWER REPLACEMENT CONTRACT NO. 2937J	
ESQUIVEL GRADING AND PAVING, INC. 918 INGERSON AVENUE SAN FRANCISCO, CA 94124	
DRAWN BY: ABDOL M. DEGHANI, P.E.	REVISION NO.
SCALE: 1" = 100'	JUNE 10, 2019 JOB NO. 2019-01 SHEET TC.61